


Latitude $38^{\circ} 35'$

Longitude $81^{\circ} 20'$

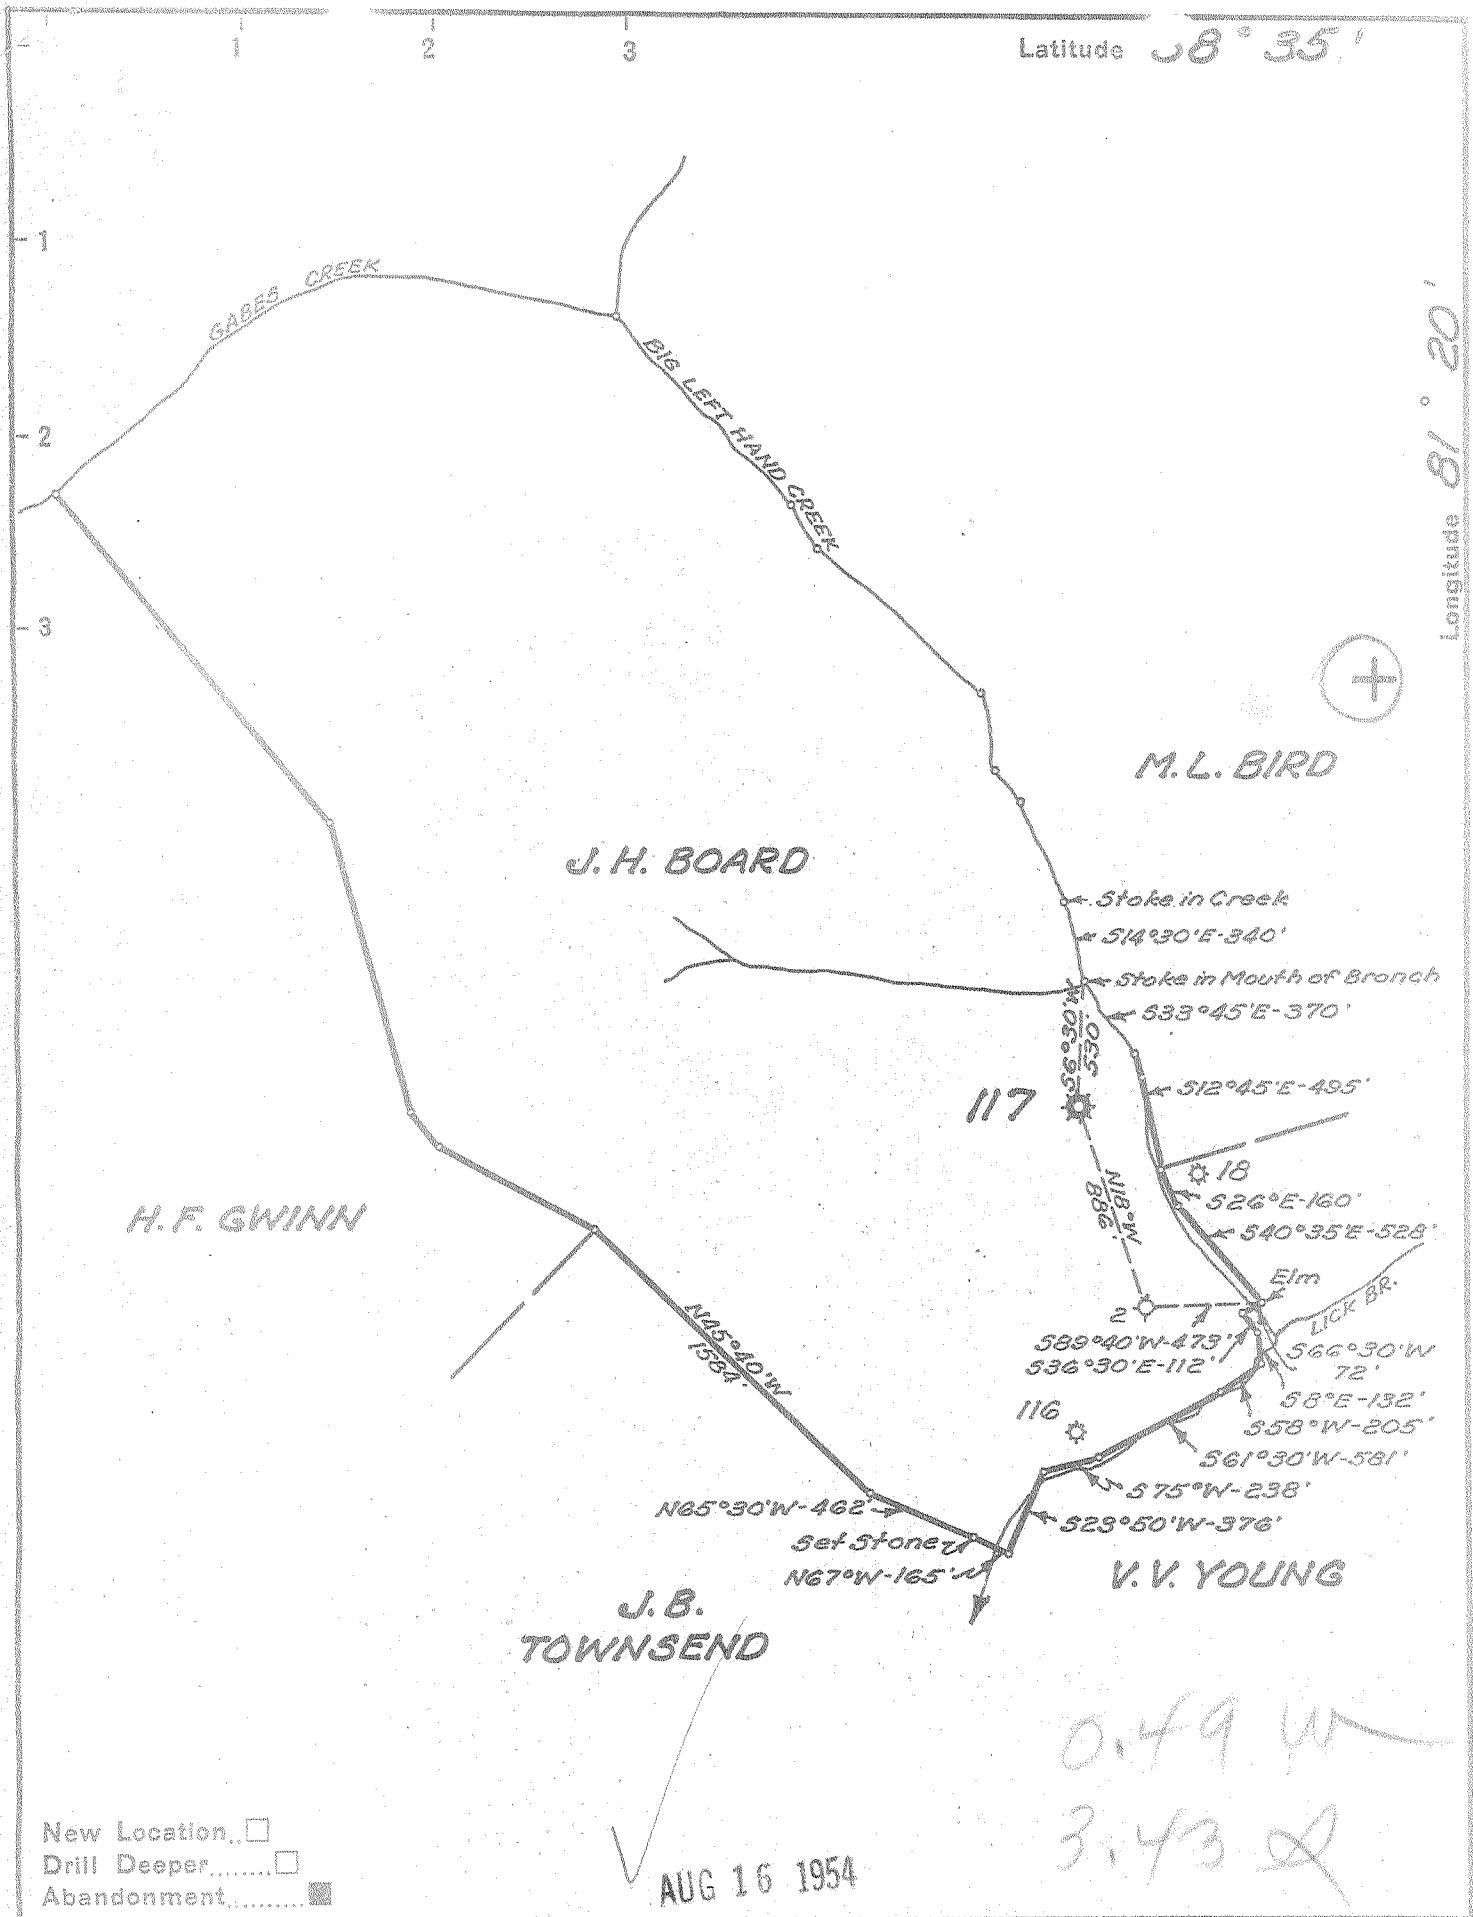

New Location
 Drill Deeper
 Abandonment

AUG 16 1954

0.49 W
 3.43 S

Company UNITED FUEL GAS CO.
 Address CHARLESTON, W.VA.
 Farm J.H. BOARD
 Tract _____ Acres 350 Lease No. 538
 Well (Farm) No. _____ Serial No. 117
 Elevation (Spirit Level) 647.5'
 Quadrangle WALTON
 County KANAWHA District BIG SANDY
 Engineer Lybert Russell
 Engineer's Registration No. 2529
 File No. 76-71 Drawing No. _____
 Date 7-29-54 Scale 1"=800'

STATE OF WEST VIRGINIA
 DEPARTMENT OF MINES
 OIL AND GAS DIVISION
 CHARLESTON

WELL LOCATION MAP

FILE NO. KAN-1064-A

was 03970609

+ Denotes location of well on United States Topographic Maps, scale 1 to 62,500, latitude and longitude lines being represented by border lines as shown.

- Denotes one inch spaces on border line of original tracing.



STATE OF WEST VIRGINIA
DEPARTMENT OF MINES
OIL AND GAS DIVISION

18-16

Quadrangle Walton

Permit No. 1067-A

WELL RECORD

Oil or Gas Well Gas
(KIND)


Company UNITED FUEL GAS CO.
Address P.O. Box 1273, Charleston 25, W. Va.
Farm J. H. Board Acres 350
Location (waters) Big Left Hand Creek
Well No. 117 Elev. 647.5'
District Big Sandy County Kanawha
The surface of tract is owned in fee by _____
Address _____
Mineral rights are owned by Cora C. Board, et al
3805 Virginia Ave. Address Charleston 4, W. Va.
Drilling commenced 5-15-07
Drilling completed 7-5-07
Date Shot _____ From _____ To _____
With _____
Open Flow _____ /10ths Water in _____ Inch
_____ /10ths Merc. in _____ Inch
Volume 5,000,000 Cu. Ft.
Rock Pressure 300 lbs. 1 Min. hrs.
Oil _____ bbls., 1st 24 hrs.
Fresh water _____ feet
Salt water 910 feet

Casing and Tubing	Used in Drilling	Left in Well	Packers
Size			
16			Kind of Packer <u>Anchor</u>
13			
10		<u>3 1/4'</u>	Size of <u>6x6 1/2 x 16"</u>
8 1/4			Depth set
6 5/8		<u>1451'</u>	
5 3/16			Perf. top
3			Perf. bottom
2			Perf. top
Liners Used			Perf. bottom

CASING CEMENTED _____ SIZE _____ No. Ft. _____ Date _____

COAL WAS ENCOUNTERED AT _____ FEET _____ INCHES
_____ FEET _____ INCHES _____ FEET _____ INCHES
_____ FEET _____ INCHES _____ FEET _____ INCHES

Formation	Color	Hard or Soft	Top	Bottom	Oil, Gas or Water	Depth Found	Remarks
Salt Sand			860	1370	Water in Salt Sand at 910' Gas at 1461', 1556' to 1585'.		
Little Lime			1370	1415			
Big Lime			1415	1550			
Big Injun			1550	1585			

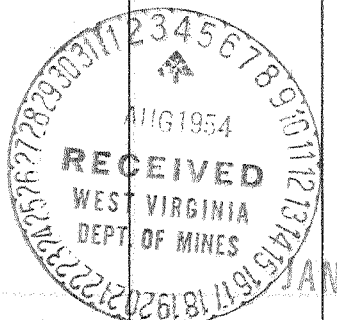

JAN 7 1955

(Over)

