



STATE OF WEST VIRGINIA
DEPARTMENT OF MINES
OIL AND GAS DIVISION

1817

WELL RECORD

Oil or Gas Well Gas
(KIND)


Quadrangle Walton
Permit No. 1069A
Company UNITED FUEL GAS CO.
Address P.O. Box 1273, Charleston 25, W. Va.
Farm Littlepage & Gardner Acres 1600
Location (waters) Gabe Creek
Well No. 1642 Elev. 893.33'
District Big Sandy County Kanawha
The surface of tract is owned in fee by _____
Address _____
Mineral rights are owned by Charleston National Bank,
Agt. Marguerite P. Littlepage interest
Address Charleston, W. Va.
Drilling commenced 10-21-26
Drilling completed 12-3-26
Date Shot _____ From _____ To _____
With _____
Open Flow 46 /10ths Water in 3 Inch
_____ /10ths Merc. in _____ Inch
Volume 719,280 Cu. Ft.
Rock Pressure 160 lbs. _____ hrs.
Oil _____ bbls., 1st 24 hrs.
Fresh water _____ feet _____ feet
Salt water 1220 feet 123 5' feet

Casing and Tubing	Used in Drilling	Left in Well	Packers
Size			
16			Kind of Packer
13			Anchor
10			Size of
8 1/4		<u>6'31</u>	<u>3x5-3/16x16</u>
6 5/8		<u>1704</u>	Depth set
5 3/16			<u>1766'</u>
3			Perf. top
2			Perf. bottom
Liners Used			Perf. top
			Perf. bottom

CASING CEMENTED _____ SIZE _____ No. Ft. _____ Date _____

COAL WAS ENCOUNTERED AT _____ FEET _____ INCHES
_____ FEET _____ INCHES
_____ FEET _____ INCHES

Formation	Color	Hard or Soft	Top	Bottom	Oil, Gas or Water	Depth Found	Remarks
Soil			0	14	First water	1220'	
Gravel & Sand			14	18			
Slate			18	40	Hole full	1235'	
Red Rock			40	60	Hole reduced	1755'	
Sand			60	75			
Slate & Lime			75	150	Gas	1818-1828	
Red Rock			150	175			
Slate & Sand			175	250			
Red Rock			250	300			
Slate & Lime			300	440			
Dunkard			440	580			
Slate & Lime			580	730			
Sand & Lime			730	880			
Slate & Shells			880	980			
Lime & Sand			980	1035			
Slate & Shells			1035	1120			
Salt Sand			1120	1337			
Slate			1337	1341			
Black Lime			1341	1381			
Sand			1381	1440			
Lime & Sand			1440	1633			
Little Lime			1633	1668			
Slate			1668	1671			
Grey Lime			1671	1681			
Slate			1681	1683			
Big Lime			1683	1816			
Big Injun			1816	1850			
Slate			1850	1878			
Total depth			1878'				

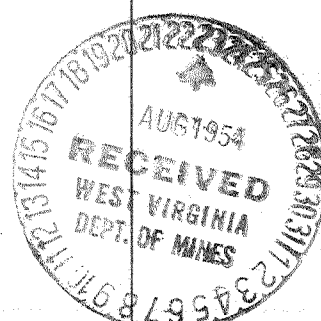

(Over)

NOV 12 1954

