

Company UNITED FUEL GAS CO.

Address CHARLESTON, W. VA.

Farm BLUE CREEK COALELAND CO.

Tract \_\_\_\_\_ Acres 26688 Lease No. 4881

Well (Farm) No. 6 Serial No. 2568

Elevation (Spirit Level) 1253

Quadrangle CLENDENIN

County KANAWHA District DIG SANDY

Engineer Seibert Russell

Engineer's Registration No. 2529

File No. 76-65 Drawing No. \_\_\_\_\_

Date 9-28-54 Scale 1"=660'

STATE OF WEST VIRGINIA  
DEPARTMENT OF MINES  
OIL AND GAS DIVISION  
CHARLESTON

WELL LOCATION MAP  
FILE NO. KAN-1084-A

+ Denotes location of well on United States Topographic Maps, scale 1 to 62,500, latitude and longitude lines being represented by border lines as shown.

- Denotes one inch spaces on border line of original tracing.

6-6-20



STATE OF WEST VIRGINIA  
DEPARTMENT OF MINES  
OIL AND GAS DIVISION

1825

WELL RECORD

Oil or Gas Well Gas  
(KIND)

Quadrangle Glendenin  
Permit No. 1084A  
Company UNITED FUEL GAS COMPANY  
Address P.O. Box 1273, Charleston 25, W. Va.  
Farm Blue Ck. C. & Land Co. Acres 26,688  
Location (waters) Leatherwood Creek  
Well No. 2568 Elev. 1253.0'  
District Big Sandy County Kanawha  
The surface of tract is owned in fee by \_\_\_\_\_

Mineral rights are owned by Carbide & Carbon Chem. Corp.  
John A. Gray Address 30 East 42nd St.  
New York, New York  
Drilling commenced 1-14-29  
Drilling completed 3-14-29  
Date Shot 3-15-29 From 2107 To 2122  
With 30 qts.


Open Flow 18 /10ths Water in \_\_\_\_\_ Inch  
/10ths Merc. in \_\_\_\_\_ Inch  
Volume 448,000 Cu. Ft.  
Rock Pressure 210 lbs. 48 hrs.  
Oil \_\_\_\_\_ bbls., 1st 24 hrs.  
Fresh water 1310 feet  
Salt water 1200' feet

Casing and Tubing	Used in Drilling	Left in Well	Packers
Size			
16			Kind of Packer
13			Anchor
10			Size of
8 1/2		<u>485'</u>	<u>3x5-3/16x16</u>
6 5/8		<u>1918'</u>	Depth set
5 3/16			<u>1941' 10"</u>
3		<u>2194'</u>	Perf. top
2			Perf. bottom
Liners Used			Perf. top
			Perf. bottom

CASING CEMENTED \_\_\_\_\_ SIZE \_\_\_\_\_ No. Ft. \_\_\_\_\_ Date \_\_\_\_\_

COAL WAS ENCOUNTERED AT 424 FEET 48 INCHES  
1293 FEET 24 INCHES FEET INCHES  
FEET INCHES FEET INCHES

Formation	Color	Hard or Soft	Top	Bottom	Oil, Gas or Water	Depth Found	Remarks
Conductor			0	16			
Red Rock			16	80			
Sand			80	140			
Red Rock			140	150			
Slate			150	225			
Sand			225	424			
Coal			424	428			
Slate			428	465			
Sand			465	636			
Slate & Shell			636	670			
Sand			670	720			
Slate & Shell			720	930			
Sand			930	980			
Slate & Shell			980	1150			
Salt Sand			1150	1293			
Coal			1293	1295			
Sand			1295	1478			
Slate			1478	1482			
Sand			1482	1645			
Slate			1645	1647			
Red Rock			1647	1653			
Slate			1653	1661			
Maxon Sand			1661	1681			
Lime & Slate			1681	1771			
Griffy Lime			1771	1785			
Slate			1785	1792			
Little Lime			1792	1816			
Slate			1816	1819			
Lime Shell			1819	1851			
Big Lime			1851	1945			
Keener Sand			1945	1990			
Big Injun Sand			1990	2028			
Weir Sand			2028	2156			
Slate			2156	2173			
Total depth			2173'				

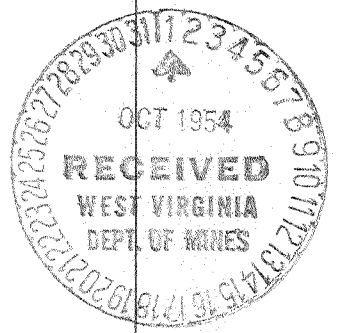

Show of oil at 1160'  
Water 1200'  
Hole full of water at 1310'

Reduced hole at 1923'  
Gas 2037', 2075-2085', 2108-2122'.

JAN 7 1955

