

New Location  
 Drill Deeper  
 Abandonment

NOV 1 1954

3.2 cu  
 J. R. Young

Company	UNITED FUEL GAS CO.		
Address	CHARLESTON, W.VA.		
Farm	J. R. YOUNG		
Tract	Acres	Lease No.	
	38	766	
Well (Farm) No.	1	Serial No.	832
Elevation (Spirit Level)	1295.0'		
Quadrangle	CLENDENIN		
County	KANAWHA District BIG SANDY		
Engineer	<i>[Signature]</i>		
Engineer's Registration No.	2529		
File No.	74-63	Drawing No.	
Date	10-5-54	Scale	1" = 400'

STATE OF WEST VIRGINIA  
 DEPARTMENT OF MINES  
 OIL AND GAS DIVISION  
 CHARLESTON

WELL LOCATION MAP  
 FILE NO. KAN-1089-A

+ Denotes location of well on United States Topographic Maps, scale 1 to 62,500, latitude and longitude lines being represented by border lines as shown.

- Denotes one inch spaces on border line of original tracing.

6-6 218

J. R. YOUNG No. 1 (832) — U. F. G. Co. — KAN-1089-A



STATE OF WEST VIRGINIA  
DEPARTMENT OF MINES  
OIL AND GAS DIVISION

1961

Quadrangle Clendenin

WELL RECORD

Permit No. 8897

Oil or Gas Well Gas  
(KIND)


Company UNITED FUEL GAS COMPANY  
Address P.O. Box 1273, Charleston 25, W. Va.  
Farm J. R. Young Acres 38  
Location (waters) Falling Rock Creek  
Well No. 832 Elev. 1295'  
District Big Sandy County Kanawha  
The surface of tract is owned in fee by \_\_\_\_\_  
Address \_\_\_\_\_  
Mineral rights are owned by Josephine Young, Agt., et al  
Address Linden, W. Va.  
Drilling commenced 6-16-16  
Drilling completed 7-20-16  
Date Shot \_\_\_\_\_ From \_\_\_\_\_ To \_\_\_\_\_  
With \_\_\_\_\_  
Open Flow \_\_\_\_\_ /10ths Water in \_\_\_\_\_ Inch  
40 /10ths Merc. in 2 Inch  
Volume 1,109,000 Cu. Ft.  
Rock Pressure 485 lbs. 48 hrs.  
Oil \_\_\_\_\_ bbls., 1st 24 hrs.  
Fresh water \_\_\_\_\_ feet \_\_\_\_\_ feet  
Salt water 1305' feet \_\_\_\_\_ feet

Casing and Tubing	Used in Drilling	Left in Well	Packers
Size			Kind of Packer
16			<u>Parmaco</u>
13			Size of
10			<u>2x6-5/8x16</u>
8 1/4	<u>565'</u>		Depth set
5 3/16		<u>1900'</u>	<u>1907</u>
3			Perf. top
2		<u>2130' 0"</u>	Perf. bottom
Liners Used			Perf. top
			Perf. bottom

CASING CEMENTED \_\_\_\_\_ SIZE \_\_\_\_\_ No. Ft. \_\_\_\_\_ Date \_\_\_\_\_

COAL WAS ENCOUNTERED AT 516 FEET 72 INCHES  
\_\_\_\_\_ FEET \_\_\_\_\_ INCHES FEET \_\_\_\_\_ INCHES  
\_\_\_\_\_ FEET \_\_\_\_\_ INCHES FEET \_\_\_\_\_ INCHES

Formation	Color	Hard or Soft	Top	Bottom	Oil, Gas or Water	Depth Found	Remarks
Clay			0	15			
Red Slate			15	30			
Sand			30	50			
Red Mud			50	200			
Sand			200	230			
Slate			230	310			
Sand			310	512			
Slate			512	516			
Coal			516	522			
Sand			522	600			
Slate			600	615			
Sand			615	700			
Slate			700	715			
Sand			715	800			
Slate			800	810			
Sand			810	850			
Slate			850	910			
Sand			910	935			
Slate			935	950			
Sand			950	985			
Shells			985	1155			
Salt Sand			1155	1675			Show gas at 1260' water at 1305'
Break			1210	1215			
Break			1430	1437			
Slate			1675	1685			Settling sand and hole filled up to 1305'
Red Rock			1685	1725			
Shells			1725	1790			
Maxon Sand			1790	1825			
Slate			1825	1840			
Little Lime			1840	1865			
Slate			1865	1872			
Lime Shell			1872	1880			
Slate			1880	1890			
Sandy Lime			1890	1894			Gas 2085' to 2108'
Pencil Cave			1894	1895			
Big Lime			1895	2055			
Big Injun			2055	2118			
Total depth			2118'				

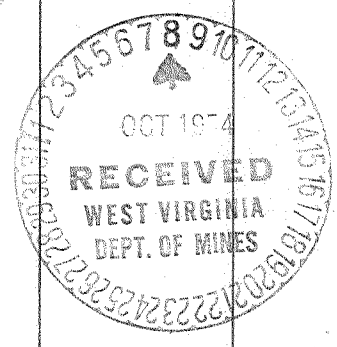

JAN. 23 1956

