

New Location
Drill Deeper
Abandonment

Company UNITED FUEL GAS CO.
Address CHARLESTON, W. VA.
Farm M.V. JARRETT
Tract _____ Acres 146 Lease No. 13269
Well (Farm) No. _____ Serial No. 1467
Elevation (Spirit Level) 825.0'
Quadrangle KENNA
County KANAWHA District ELK
Engineer _____
Engineer's Registration No. 2529
File No. 6B-69 Drawing No. _____
Date 10-6-54 Scale 1"=400'

STATE OF WEST VIRGINIA
DEPARTMENT OF MINES
OIL AND GAS DIVISION
CHARLESTON

WELL LOCATION MAP
FILE NO. KAN-1092-A

+ Denotes location of well on United States Topographic Maps, scale 1 to 62,500, latitude and longitude lines being represented by border lines as shown.
- Denotes one inch spaces on border line of original tracing.

NOV 1 1954

W.J. PATTERSON, HRS.

472

M.V. JARRETT No. 1467 - U.F.G. Co. - KAN-1092-A



STATE OF WEST VIRGINIA
DEPARTMENT OF MINES
OIL AND GAS DIVISION

1467

Quadrangle Kenna

WELL RECORD

Oil or Gas Well Gas

(KIND)

Permit No. _____

Company UNITED FUEL GAS CO.

Address P.O. Box 1273, Charleston 25, W. Va.

Farm M. V. Jarrett Acres 146

Location (waters) Pocataligo Fork

Well No. 1467 Elev. 825'

District Elk County Kanawha

The surface of tract is owned in fee by _____
Address _____

Mineral rights are owned by William B. Jarrett, et al
Agt. R.F.D. 5 Box 456-A Address Charleston, W. Va.

Drilling commenced 1-20-25

Drilling completed 3-1-25

Date Shot 3-5-25 From _____ To _____

With 30 qts.

Open Flow 7 /10ths Water in _____ 3 Inch
_____ /10ths Merc. in _____ Inch

Volume 284,040 Cu. Ft.

Rock Pressure 350 lbs. _____ hrs.

Oil _____ bbls., 1st 24 hrs.

Fresh water _____ feet _____ feet


Salt water 1305 feet _____ feet

Casing and Tubing	Used in Drilling	Left in Well	Packers
Size			
16			Kind of Packer
13			<u>Anchor</u>
10			Size of
8 1/4	<u>560'</u>		<u>3x5-3/16x16</u>
6 5/8		<u>1773'8"</u>	Depth set
5 3/16			<u>1856'</u>
3		<u>1964'9"</u>	Perf. top
2			Perf. bottom
Liners Used			Perf. top
			Perf. bottom

CASING CEMENTED _____ SIZE _____ No. Ft. _____ Date _____

COAL WAS ENCOUNTERED AT _____ FEET _____ INCHES
_____ FEET _____ INCHES _____ FEET _____ INCHES
_____ FEET _____ INCHES _____ FEET _____ INCHES

Formation	Color	Hard or Soft	Top	Bottom	Oil, Gas or Water	Depth Found	Remarks
Soil			0	16			
Slate			16	65			Hole full water 1305'
Red Rock			65	80			Hole reduced 1838'
Slate & Shells			80	360			Gas Big Injun 1904-1911
Sand & Slate			360	685			
Slate & Shells			685	820			
Sand & Slate			820	1090			
Slate & Shells			1090	1225			
Salt Sand			1225	1503			
Lime			1503	1550			
Maxon Sand			1550	1690			
Slate			1690	1700			
Little Lime			1700	1728			
Slate			1728	1733			
Lime Shell			1733	1736			
Pencil Cave			1736	1739			
Big Lime			1739	1900			
Big Injun			1900	1915			
Slate			1915	1948			
Total depth			1948'				

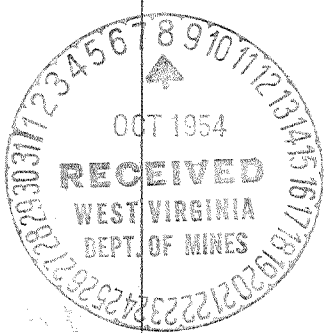

OCT 6 1955

