

New Location
Drill Deeper
Abandonment

NOV 1 1954

3.00 W
3.18 Q

Company **UNITED FUEL GAS CO.**
 Address **CHARLESTON, W. VA.**
 Farm **J. M. STAUNTON**
 Tract Acres **876** Lease No. **19212**
 Well Farm No. **6** Serial No. **1253**
 Elevation Spirit Level **909.92'**
 Quadrangle **CLENDENIN**
 County **KANAWHA** District **ELK**
 Engineer **W. H. ...**
 Engineer's Registration No. **2529**
 File No. **70-59** Drawing No. _____
 Date **10-5-54** Scale **1"=500'**

STATE OF WEST VIRGINIA
DEPARTMENT OF MINES
OIL AND GAS DIVISION
CHARLESTON

WELL LOCATION MAP
FILE NO. **KAN-1094-A**

+ Denotes location of well on United States Topographic Maps, scale 1 to 62,500; latitude and longitude lines being represented by border lines as shown.

- Denotes one inch spaces on border line of original tracing.

6-6 216



STATE OF WEST VIRGINIA
DEPARTMENT OF MINES
OIL AND GAS DIVISION

1959

Quadrangle Clendenin

Permit No. 1094-A

WELL RECORD

Oil or Gas Well Gas
(KIND)

Company UNITED FUEL GAS CO.
Address P.O. Box 1273, Charleston 25, W. Va.
Farm J. M. Staunton Acres 876
Location (waters) Mill Creek
Well No. 1253 Elev. 909.92'
District ELK County Kanawha

The surface of tract is owned in fee by _____

Mineral rights are owned by Fredrick M. Staunton & Kath-
erine S. Thomas, Admrs.
Kanawha Banking & Tst. Co., Charleston, W. Va.

Drilling commenced 7-17-12

Drilling completed 9-6-12

Date Shot _____ From _____ To _____

With _____

Open Flow 8 /10ths Water in _____ Inch

2 /10ths Merc. in _____ Inch

Volume 497,000 Cu. Ft.

Rock Pressure 276 lbs. _____ hrs.

Oil _____ bbls., 1st 24 hrs.

Fresh water 27 feet 125 feet


Salt water 780 feet 920 feet

Casing and Tubing	Used in Drilling	Left in Well	Packers
Size			Kind of Packer
16			
18			
10		45'	Size of
8 1/4	574		2x5-3/16
6 5/8		1427	Depth set
5 3/16			
3			Perf. top
2		1825'	Perf. bottom
Liners Used			Perf. top
			Perf. bottom

CASING CEMENTED _____ SIZE _____ No. Ft. _____ Date _____

COAL WAS ENCOUNTERED AT 65 FEET 24 INCHES
187 FEET 36 INCHES 218 FEET 48 INCHES
_____ FEET _____ INCHES _____ FEET _____ INCHES

Formation	Color	Hard or Soft	Top	Bottom	Oil, Gas or Water	Depth Found	Remarks
Sand			20	45	Water 27, 125'		
Coal			65	67			
Sand			70	100			
Sand			110	145			
Coal			187	190			
Coal			218	222			
Sand			285	340			
Sand			470	508			
Sand			529	570			
Sand			590	632			
Lime			666	700	Little Gas 765'. Water 780 filled up 920'		
Salt Sand			720	1206			
Lime			1266	1330			
Red Rock			1346	1372			
Lime			1372	1398			
Little Lime			1412	1456			
Pencil Cave			1456	1465			
Big Lime			1465	1624			
Big Injun			1624	1650			
Red Rock			1650	1662			
Injun			1688	1811	Gas 1575'		
1st Pay			1702	1718			
2nd Pay			1752				
Total depth			1825'				

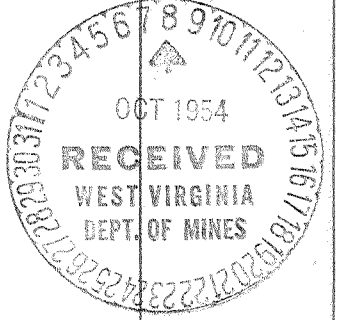

JAN 23 1956

Formation	Color	Hard or Soft	Top	Bottom	Oil, Gas or Water	Depth Found	Remarks

Date October 6, 1954

APPROVED UNITED FUEL GAS CO., Owner

By S. R. Ferrell
(Title)

Mgr. Civil Engr. Department