

New Location
 Drill Deeper
 Abandonment

Company UNITED FUEL GAS CO.
 Address CHARLESTON, W. VA.
 Farm J. M. STAUNTON
 Tract _____ Acres 876 Lease No. 19212
 Well (Farm) No. 7 Serial No. 1254
 Elevation (Spirit Level) 890.10'
 Quadrangle CLENDENIN
 County KANAWHA District ELK
 Engineer [Signature]
 Engineer's Registration No. 2529
 File No. 70-59 Drawing No. _____
 Date 10-5-54 Scale 1"=500'

STATE OF WEST VIRGINIA
 DEPARTMENT OF MINES
 OIL AND GAS DIVISION
 CHARLESTON

WELL LOCATION MAP
 FILE NO. KAN-1095-A

3095
 + Denotes location of well on United States Topographic Maps, scale 1 to 62,500, latitude and longitude lines being represented by border lines as shown.
 - Denotes one inch spaces on border line of original tracing.

6-6-216



STATE OF WEST VIRGINIA
DEPARTMENT OF MINES
OIL AND GAS DIVISION

1954

WELL RECORD

Oil or Gas Well Gas
(KIND)


Quadrangle Clendenin
Permit No. 1254
Company UNITED FUEL GAS COMPANY
Address P.O. Box 1273, Charleston 25, W. Va.
Farm J. M. Staunton Acres 876
Location (waters) Rt. Fork of Mill Creek
Well No. 1254 Elev. 890.10'
District Elk County Kanawha
The surface of tract is owned in fee by _____
Address _____
Mineral rights are owned by Fredrick M. Staunton & Katherine S. Thomas % Kanawha Banking & Tst. Co.
Address Charleston, W. Va.

Casing and Tubing	Used in Drilling	Left in Well	Packers
Size			Kind of Packer
16			<u>Anchor</u>
13			Size of
10	<u>154'</u>		<u>2x6-5/8</u>
8 1/4	<u>501'</u>		Depth set
6 5/8		<u>1441'</u>	<u>1587'</u>
5 3/16			Perf. top
3			Perf. bottom
2		<u>1726</u>	Perf. top
Liners Used			Perf. bottom

Drilling commenced _____
Drilling completed 1-6-1913 JFG Prod JM
Date Shot From _____ To _____
With _____
Open Flow 6 /10ths Water in _____ 2 Inch
_____ /10ths Merc. in _____ Inch
Volume 116,000 Cu. Ft.
Rock Pressure 303 lbs. _____ hrs.
Oil _____ bbls., 1st 24 hrs.
Fresh water 35 feet _____ feet
Salt water _____ feet _____ feet

CASING CEMENTED _____ SIZE _____ No. Ft. _____ Date _____
COAL WAS ENCOUNTERED AT 75 FEET 24 INCHES
134 FEET 36 INCHES 188 FEET 24 INCHES
202 FEET 48 INCHES FEET INCHES

Formation	Color	Hard or Soft	Top	Bottom	Oil, Gas or Water	Depth Found	Remarks
Sand			15	72	Water 35		
Coal			75	77			
Sand			85	128			
Coal			134	137			
Coal			188	190			
Coal			202	206			
Sand			450	522			
Sand			545	586			
Lime			595	612			
Salt Sand			645	1185	Show of oil 775'		
Lime			1240	1308			
Red Rock			1308	1335			
Lime			1335	1364			
Little Lime			1380	1431			
Pencil Cave			1431	1440			
Big Lime			1440	1596			
1st Big Injun			1596	1603			
Little Oil & Gas			1595				
Red Rock			1603	1640			
Black Sand Broken			1714	1835			
Black Slate			1835	2040			
Coffee Slate			2040	2074			
Slate & Shells			2074	2702			
Total depth			2702				

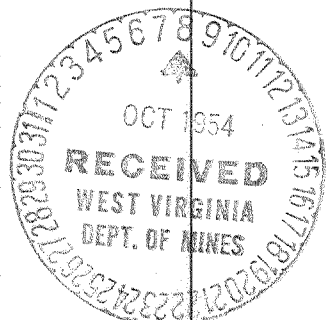

OCT 6 1955

