

New Location  
 Drill Deeper  
 Abandonment

NOV 1 1954

1973 W  
 3109 Q

Company UNITED FUEL GAS CO.  
 Address CHARLESTON, W. VA.  
 Farm ASA CANTERBURY  
 Tract \_\_\_\_\_ Acres 344 Lease No. 832  
 Well (Farm) No. 1 Serial No. 180  
 Elevation (Spirit Level) 946.5'  
 Quadrangle WALTON  
 County KANAWHA District BIG SANDY  
 Engineer \_\_\_\_\_  
 Engineer's Registration No. 2529  
 File No. 70-71 Drawing No. \_\_\_\_\_  
 Date 10-5-54 Scale 1"=400'

STATE OF WEST VIRGINIA  
 DEPARTMENT OF MINES  
 OIL AND GAS DIVISION  
 CHARLESTON

WELL LOCATION MAP  
 FILE NO. KAN-1100-A

+ Denotes location of well on United States Topographic Maps, scale 1 to 62,500, latitude and longitude lines being represented by border lines as shown.

- Denotes one inch spaces on border line of original tracing.

66 198

ASA CANTERBURY No. 1 (180) - U. F. G. Co. - KAN-1100-A



STATE OF WEST VIRGINIA  
DEPARTMENT OF MINES  
OIL AND GAS DIVISION

1944

Quadrangle Walton  
Permit No. 11027

WELL RECORD


Oil or Gas Well Gas  
(KIND)

Company UNITED FUEL GAS COMPANY  
 Address P.O. Box 127, Charleston 25, W. Va.  
 Farm Asa Canterbury Acres 344  
 Location (waters) Rucker Fork  
 Well No. 180 Elev. 946.5'  
 District Big Sandy County Kanawha  
 The surface of tract is owned in fee by \_\_\_\_\_  
 Address \_\_\_\_\_  
 Mineral rights are owned by Tressie Bird, et al  
Rt. 1 Address Centerburg, Ohio  
 Drilling commenced 10-10-10  
 Drilling completed 11-20-10  
 Date Shot \_\_\_\_\_ From \_\_\_\_\_ To \_\_\_\_\_  
 With \_\_\_\_\_  
 Open Flow 4 /10ths Water in 6-5/8 Inch  
 \_\_\_\_\_ /10ths Merc. in \_\_\_\_\_ Inch  
 Volume 3,214,000 Cu. Ft.  
 Rock Pressure 445 lbs. \_\_\_\_\_ hrs.  
 Oil \_\_\_\_\_ bbls., 1st 24 hrs.  
 Fresh water \_\_\_\_\_ feet \_\_\_\_\_ feet  
 Salt water \_\_\_\_\_ feet \_\_\_\_\_ feet

Casing and Tubing	Used in Drilling	Left in Well	Packers
Size			
16			Kind of Packer
13			<u>Callanan</u>
10			Size of
8 1/4	<u>710'</u>		<u>3x6-5/8x16</u>
6 5/8		<u>1770'</u>	Depth set
5 3/16			<u>1801</u>
3			Perf. top
2			Perf. bottom
Liners Used			Perf. top
			Perf. bottom

CASING CEMENTED \_\_\_\_\_ SIZE \_\_\_\_\_ No. Ft. \_\_\_\_\_ Date \_\_\_\_\_  
 COAL WAS ENCOUNTERED AT 720 FEET 48 INCHES  
 \_\_\_\_\_ FEET \_\_\_\_\_ INCHES FEET \_\_\_\_\_ INCHES  
 \_\_\_\_\_ FEET \_\_\_\_\_ INCHES FEET \_\_\_\_\_ INCHES

Formation	Color	Hard or Soft	Top	Bottom	Oil, Gas or Water	Depth Found	Remarks
Conductor				16			
Sand			16	140			
Red Rock			140	500			
Lime			500	550			
Dunkard Sand			550	670			
Slate			670	720			
Coal			720	724			
Sand			724	825			
Broken			825	936			
Lime Shells			936	1020			
Shale			1020	1070			
Lime			1070	1140			
Shale			1140	1160			
Lime			1160	1190			
Sand			1190	1230			
Slate			1230	1250			
Salt Sand			1250	1690			
Maxon Sand			1690	1720			
Little Lime			1720	1759			
Big Lime			1759	1871			
Keener Sand			1871	1891			
Big Injun			1891	1931			
Bottom of Hole (Slate)			1931	1936			
							Little gas Gas at 1895' and 1910'

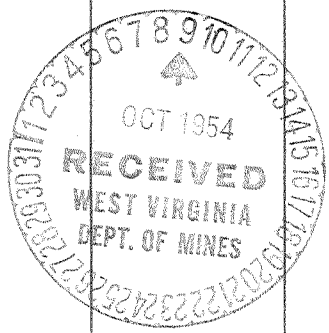

JAN. 23 1956

Formation	Color	Hard or Soft	Top	Bottom	Oil, Gas or Water	Depth Found	Remarks

Date October 4, 19 54

APPROVED UNITED FUEL GAS CO., Owner

By S.R. Farrell  
 Mgr. Civil (Title) Department