

New Location
 Drill Deeper
 Abandonment

✓ 1285

NOV 1 1954

1.95 W
 3.112 Q

Company UNITED FUEL GAS CO.
 Address CHARLESTON, W. VA.
 Farm BETTY N BIRD
 Tract _____ Acres 30 Lease No. 10775
 Well (Farm) No. _____ Serial No. 1284
 Elevation (Spirit Level) 860.00'
 Quadrangle WALTON
 County KANAWHA District BIG SANDY
 Engineer _____
 Engineer's Registration No. 2529
 File No. 76-71 Drawing No. _____
 Date 10-14-54 Scale 1" = 400'

STATE OF WEST VIRGINIA
 DEPARTMENT OF MINES
 OIL AND GAS DIVISION
 CHARLESTON

WELL LOCATION MAP
 FILE NO. KAN-1111-A

+ Denotes location of well on United States Topographic Maps, scale 1 to 62,500, latitude and longitude lines being represented by border lines as shown.

- Denotes one inch spaces on border line of original tracing.

6-6 220

BETTY N. BIRD No. 1284 — U. F. G. Co. — KAN-1111-A

LOCAL OPERATOR OR OWNER

ADDRESS

LOCAL OPERATOR OR OWNER

WELL AND LOCATION

19

Big Sandy

District

Ethel Bird Young, et al

Kanawha

County

LEASE OR PROPERTY OWNER

Well No. 1284

205 Glenwood Ave.
Charleston, W. Va.

Betty N. Bird

Farm

STATE INSPECTOR SUPERVISING PLUGGING

AFFIDAVIT

STATE OF WEST VIRGINIA.

County of Kanawha

C. W. Kelly

and Charles Bryson

being first duly sworn according to law depose and say that they are experienced in the work of plugging and filling oil and gas wells and were employed by Service Pipe and Supply Company well operator, and participated in the work of plugging and filling the above well, that said work was commenced on the 2 day of December, 1954, and that the well was plugged and filled in the following manner:

SAND OR ZONE RECORD	FILLING MATERIAL	PLUGS USED	CASING	
			CSG PULLED	CSG LEFT IN
FORMATION		SIZE & KIND		
Pulled 3" rig pipe at 1818' Filled to 1864'				
Filled with clay from 1864' to 1667' crushed stone from 1667' to 1677' and cement from 1677' to 1667' sealing off the Big Injun and Big Lime horizons.				
Pull 1657' of 6-5/8" casing as balance of hole is filled and plugged.				
Set permanent bridge at 1830' and fill with crushed stone from 1480' to 1470', cement from 1470' to 1460', clay from 1660' to 1150', crushed stone from 1150' to 1140', cement from 1140' to 1130' to 1110' sealing off the Salt Sand formation.				
Set permanent bridge at 300' and fill with crushed stone from 300' to 290', cement from 290' to 280' and clay from 280' to surface.				
Erect monument as prescribed by law.				
COAL SEAMS			DESCRIPTION OF MONUMENT	
(NAME)			7" x 7 ft. long	
(NAME)			Inscription	
(NAME)			URG #1284	
(NAME)			Aug. 12, 20, 54	

and that the work of plugging and filling said well was completed on the 20 day of December, 1954.

And further deponents saith not.

Sworn to and subscribed before me this 24 day of December, 1954.

My commission expires:

August 30, 1956

C. W. Kelly
Charles Bryson
Notary Public

Kan III



STATE OF WEST VIRGINIA
DEPARTMENT OF MINES
OIL AND GAS DIVISION

1858

WELL RECORD

Oil or Gas Well Gas
(KIND)


Quadrangle Walton
Permit No. 1117

Company UNITED FUEL GAS CO.
Address P.O. Box 1273, Charleston 25, W. Va.
Farm Betty N. Bird Acres 30
Location (waters) Gabe Creek
Well No. 1284 Elev. 860.0'
District Big Sandy County Kanawha
The surface of tract is owned in fee by _____
Address _____
Mineral rights are owned by Ethel Bird Young, et al
205 Glenwood Ave. Address Charleston, W. Va.
Drilling commenced 1-9-23
Drilling completed 2-27-23
Date Shot _____ From _____ To _____
With _____
Open Flow 4 10ths Water in 3 Inch
_____ /10ths Merc. in _____ Inch
Volume 260,900 Cu. Ft.
Rock Pressure 290 lbs. _____ hrs.
Oil _____ bbls., 1st 24 hrs.
Fresh water _____ feet
Salt water _____ feet

Casing and Tubing	Used in Drilling	Left in Well	Packers
Size			
16			Kind of Packer _____
13			<u>Anchor</u>
10			Size of _____
8 3/4	<u>573</u>	<u>320</u>	<u>3" x 5-3/16"</u>
6 3/4		<u>1670</u>	Depth set _____
5 3/16			<u>1764</u>
3		<u>1879'</u>	Perf. top _____
2			Perf. bottom _____
Liners Used _____			Perf. top _____
			Perf. bottom _____

CASING CEMENTED _____ SIZE _____ No. Ft. _____ Date _____
COAL WAS ENCOUNTERED AT _____ FEET _____ INCHES
_____ FEET _____ INCHES FEET _____ INCHES
_____ FEET _____ INCHES FEET _____ INCHES

Formation	Color	Hard or Soft	Top	Bottom	Oil, Gas or Water	Depth Found	Remarks
Red Rock			0	20			
Sand			20	50			
Slate			50	210	Gas in Lime at 1700'		Oil shot 1742'
Sand			210	240	Reduced hole 1744'		
Slate			240	290	Gas 1794		
Sand			290	320			
Slate			320	480			
Sand			480	510			
Slate			510	540			
Sand			540	600			
Slate			600	660			
Sand			660	710			
Slate			710	940			
Sand			940	960			
Slate			960	1080			
Sand			1080	1112			
Slate			1112	1130			
Salt Sand			1130	1480			
Maxon Sand			1480	1605			
Little Lime			1605	1637			
Lime Shells			1637	1649			
Pencil Cave			1649	1653			
Big Lime			1653	1784			
Big Injur.			1784	1827			
Slate			1827	1864			
Total depth			1864'				

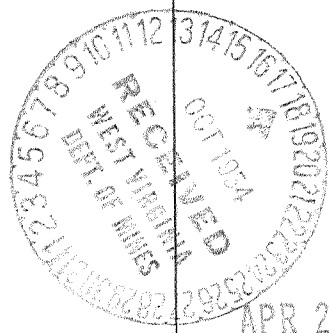

APR 22 1955

