

Company UNITED FUEL GAS CO

Address CHARLESTON, W.VA.

Farm M.M. HENDERSON

Tract \_\_\_\_\_ Acres 45 Lease No. 4974

Well (Farm) No. 2 Serial No. 1543

Elevation (Spirit Level) 998.0'

Quadrangle WALTON

County KANAWHA District ELK

Engineer Seibert R. Skell

Engineer's Registration No. 2529

File No. 70-71 Drawing No. \_\_\_\_\_

Date 10-9-54 Scale 1"=400'

STATE OF WEST VIRGINIA  
DEPARTMENT OF MINES  
OIL AND GAS DIVISION  
CHARLESTON

WELL LOCATION MAP  
FILE NO. KAN-1114-A

+ Denotes location of well on United States Topographic Maps, scale 1 to 62,500, latitude and longitude lines being represented by border lines as shown.

- Denotes one inch spaces on border line of original tracing.

6-6 192

M.M. HENDERSON No 2 (1543) - U.F.G. Co. - KAN-1114-A



STATE OF WEST VIRGINIA  
DEPARTMENT OF MINES  
OIL AND GAS DIVISION

1922

WELL RECORD

Quadrangle Walton

Permit No. \_\_\_\_\_

Oil or Gas Well Gas  
(KIND)


Company UNITED FUEL GAS CO.  
Address P.O. Box 1273, Charleston 25, W. Va.  
Farm M. M. Henderson Acres 45  
Location (waters) Pocataligo Fork  
Well No. 1543 Elev. 998'  
District Elk County Kanawha  
The surface of tract is owned in fee by \_\_\_\_\_  
Address \_\_\_\_\_  
Mineral rights are owned by M. M. Henderson  
Address Spencer, W. Va.  
Drilling commenced 2-10-26  
Drilling completed 4-1-26  
Date Shot \_\_\_\_\_ From \_\_\_\_\_ To \_\_\_\_\_  
With \_\_\_\_\_  
Open Flow 13 /10ths Water in 3 Inch  
\_\_\_\_\_ /10ths Merc. in \_\_\_\_\_ Inch  
Volume 339, 120 Cu. Ft.  
Rock Pressure 200 lbs. \_\_\_\_\_ hrs.  
Oil \_\_\_\_\_ bbls., 1st 24 hrs.  
Fresh water \_\_\_\_\_ feet \_\_\_\_\_ feet  
Salt water 1420 feet 1520 feet

Casing and Tubing	Used in Drilling	Left in Well	Packers
Size			Kind of Packer
16			
13			
10			Size of _____
8 1/4		<u>605'</u>	
6 5/8		<u>1857'</u>	Depth set _____
5 3/16			
3			Perf. top _____
<del>2 1/2</del>		<u>2041'</u>	Perf. bottom _____
Liners Used			Perf. top _____
			Perf. bottom _____


CASING CEMENTED \_\_\_\_\_ SIZE \_\_\_\_\_ No. Ft. \_\_\_\_\_ Date \_\_\_\_\_

COAL WAS ENCOUNTERED AT 1616 FEET 36 INCHES  
\_\_\_\_\_  
FEET INCHES FEET INCHES  
\_\_\_\_\_  
FEET INCHES FEET INCHES

Formation	Color	Hard or Soft	Top	Bottom	Oil, Gas or Water	Depth Found	Remarks
Slate			0	70			
Sand			70	195			
Slate			195	250			
Red Rock Slate			250	550			
Slate & Shells			550	643			
Sand			643	815			
Slate & Shells			815	924			
Slate			924	988			
Sand			988	1060			
Slate			1060	1090			
Slate & Shells			1090	1270			
Sand			1270	1312			
Slate & Shells			1312	1350			
1st Salt Sand			1350	1395			
Slate			1395	1400			
2nd Salt Sand			1400	1616			
Coal			1616	1619			
Lime			1619	1669			
Sand			1669	1725			
Slate & Shells			1725	1786			
Little Lime			1786	1810			
Pencil Cave			1810	1815			
Big Lime			1815	1954			
Big Injun			1954	1994			
Slate			1994	2023			
Total depth			2023				

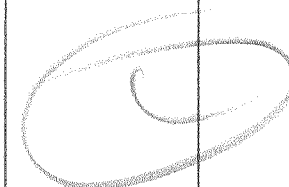

Gas 1420', 1900', 1956-1971'.  
Water 1420' 4 bailers per hr.  
Water 1520' hole full

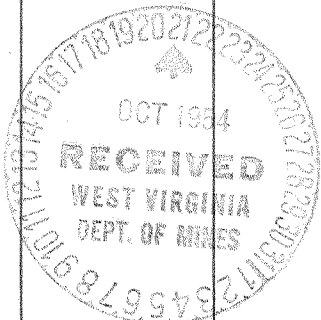

OCT 6 1955

