

New Location   
 Drill Deeper   
 Abandonment

NOV 8 1954

*Handwritten:*  
 4.500 W  
 1.14 R

Company UNITED FUEL GAS CO.  
 Address CHARLESTON, W. VA.  
 Farm W.A. PHILLIPS  
 Tract \_\_\_\_\_ Acres 300 Lease No. 14335  
 Well (Farm) No. 4 Serial No. 782  
 Elevation (Spirit Level) 786.3'  
 Quadrangle CLENDENIN  
 County KANAWHA District ELK  
 Engineer Seibert R. Jewell  
 Engineer's Registration No. 2529  
 File No. 72-61 Drawing No. \_\_\_\_\_  
 Date 10-20-54 Scale 1" = 400'

STATE OF WEST VIRGINIA  
 DEPARTMENT OF MINES  
 OIL AND GAS DIVISION  
 CHARLESTON

WELL LOCATION MAP  
 FILE NO. KAN-1115-A

+ Denotes location of well on United States Topographic Maps, scale 1 to 62,500, latitude and longitude lines being represented by border lines as shown.

- Denotes one inch spaces on border line of original tracing.

*Handwritten:* 6-6-216

W.A. PHILLIPS No. A(782) - U.F.G. Co. - KAN-1115-A



STATE OF WEST VIRGINIA  
DEPARTMENT OF MINES  
OIL AND GAS DIVISION

1930

WELL RECORD

Oil or Gas Well Gas  
(KIND)

Quadrangle Clendenin  
Permit No. 1115A

Company UNITED FUEL GAS CO.  
Address P.O. Box 1273, Charleston 25, W. Va.  
Farm Alfred Phillips Acres 446-1/4  
Location (waters) Blue Creek  
Well No. 782 Elev. 786.3  
District Elk County Kanawha  
The surface of tract is owned in fee by \_\_\_\_\_  
Address \_\_\_\_\_  
Mineral rights are owned by Marie W. Imboden, Agt., etal  
3611 Noyes Ave. Address Charleston, W. Va.  
Drilling commenced 1-9-13  
Drilling completed 2-28-13  
Date Shot \_\_\_\_\_ From \_\_\_\_\_ To \_\_\_\_\_  
With \_\_\_\_\_


Casing and Tubing	Used in Drilling	Left in Well	Packers
Size			Kind of Packer
16			
13		15'	
10		87'	Size of
8 1/4	1138'		
6 5/8		1390'	Depth set
5 3/16			
3			Perf. top
2		1790'	Perf. bottom
Liners Used			Perf. top
			Perf. bottom

Open Flow \_\_\_\_\_ /10ths Water in \_\_\_\_\_ Inch  
\_\_\_\_\_ /10ths Merc. in \_\_\_\_\_ Inch  
Volume 248,000 *from Big line UFG data DLM 6-22-94* Cu. Ft.  
Rock Pressure 145 lbs. \_\_\_\_\_ hrs.  
Oil \_\_\_\_\_ bbls., 1st 24 hrs.  
Fresh water \_\_\_\_\_ feet \_\_\_\_\_ feet  
Salt water 670 feet 725 feet

CASING CEMENTED \_\_\_\_\_ SIZE \_\_\_\_\_ No. Ft. \_\_\_\_\_ Date \_\_\_\_\_

COAL WAS ENCOUNTERED AT \_\_\_\_\_ FEET \_\_\_\_\_ INCHES  
\_\_\_\_\_ FEET \_\_\_\_\_ INCHES FEET \_\_\_\_\_ INCHES  
\_\_\_\_\_ FEET \_\_\_\_\_ INCHES FEET \_\_\_\_\_ INCHES

Formation	Color	Hard or Soft	Top	Bottom	Oil, Gas or Water	Depth Found	Remarks
Coal			380				
Salt Sand			580	1138			
Maxon Sand or Little Line			1310				First water 670' filled up 725'
Red Rock			1150	1190			Drilled by Hamilton Natural Gas Co. Purchased by U.F.G.Co. April 1916
Little Line			1285				
Big Gas			1392				
Slate			1440	1450			
Red Rock			1450	1475			
Big Injun Sand			1475	1600			
Broken			1600	1640			
Weir Sand			1640				
Total depth			1790'				94 MCF 10F WATER from UFG Prod records DLM 6/22/94

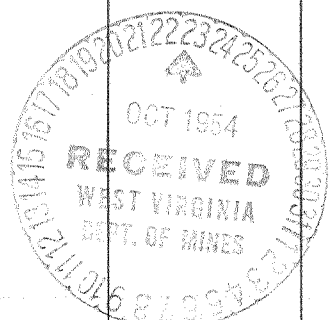

OCT 6 1955

Formation	Color	Hard or Soft	Top	Bottom	Oil, Gas or Water	Depth Found	Remarks

Date October 21, 19 54

APPROVED UNITED FUEL GAS CO., Owner

By S.R. Ferrell  
 (Title)  
 Mgr. Civil Engineering Dept.