

New Location
 Drill Deeper
 Abandonment

NOV 8 1954

3.36
 0.16

Company **UNITED FUEL GAS CO.**
 Address **CHARLESTON, W. VA.**
 Farm **E. F. COLEMAN**
 Tract _____ Acres **12 1/3** Lease No. **10736**
 Well (Farm) No. _____ Serial No. **524**
 Elevation (Spirit Level) **709.0**
 Quadrangle **CLENDENIN**
 County **KANAWHA** District **BIG SANDY**
 Engineer **Seybert R. Russell**
 Engineer's Registration No. **2529**
 File No. **69-74** Drawing No. _____
 Date **10-21-54** Scale **1" = 400'**

STATE OF WEST VIRGINIA
 DEPARTMENT OF MINES
 OIL AND GAS DIVISION
 CHARLESTON

WELL LOCATION MAP
 FILE NO. **KAN-1120-A**

+ Denotes location of well on United States Topographic Maps, scale 1 to 62,500, latitude and longitude lines being represented by border lines as shown.

- Denotes one inch spaces on border line of original tracing.

6-6-220



STATE OF WEST VIRGINIA
DEPARTMENT OF MINES
OIL AND GAS DIVISION

1885

WELL RECORD

Quadrangle Clendenin

Permit No. 1170 4


Oil or Gas Well Gas
(KIND)

Company UNITED FUEL GAS CO.
Address P.O. Box 1273, Charleston 25, W. Va.
Farm B. F. Coleman Acres 12-1/3
Location (waters) Jordan Creek
Well No. 524 Elev. 709'
District Big Sandy County Kanawha
The surface of tract is owned in fee by _____
Address _____
Mineral rights are owned by Ruth Robertson Markham, et al
2310 Adden St. Address Orange, Texas
Drilling commenced 11-14-12
Drilling completed 2-7-13
Date Shot _____ From _____ To _____
With _____
Open Flow _____ /10ths Water in _____ Inch
_____ /10ths Merc. in _____ Inch
Volume 3,175,000 Cu. Ft.
Rock Pressure _____ lbs. _____ hrs.
Oil _____ bbls., 1st 24 hrs.
Fresh water _____ feet _____ feet
Salt water 985 feet _____ feet

Casing and Tubing	Used in Drilling	Left in Well	Packers
Size			
16			Kind of Packer
13			<u>Anchor</u>
10		<u>41'</u>	Size of
8 1/4	<u>440'</u>		<u>3x5-3/16</u>
6 5/8		<u>1512'</u>	Depth set
5 3/16			
3		<u>1710'</u>	Perf. top
<u>x 1 1/2</u>		<u>1705'</u>	Perf. bottom
Liners Used			Perf. top
			Perf. bottom

CASING CEMENTED _____ SIZE _____ No. Ft. _____ Date _____
COAL WAS ENCOUNTERED AT 360 FEET 120 INCHES
_____ FEET _____ INCHES FEET _____ INCHES
_____ FEET _____ INCHES FEET _____ INCHES

Formation	Color	Hard or Soft	Top	Bottom	Oil, Gas or Water	Depth Found	Remarks
Clay				12	Hole full of water at 985'		
Sand			12	98			
Slate			98	174	Note: This well was drilled 1890' and plugged back to 1694'.		
Sand			174	227			
Slate			227	340			
Sand			340	360			
Coal			360	370			
Sand			370	440			
Slate			440	458			
Sand			458	500			
Slate			500	640			
Sand			640	680			
Slate			680	900			
Salt Sand			900	1318			
Slate			1318	1370			
Lime Shells			1370	1415			
Maxon Sand			1415	1465			
Little Lime			1465	1497			
Big Lime			1497	1632			
Injun Sand			1632	1665	Gas in Injun 1647-1662'		
Slate & Shells			1665	1835			
Weir Sand			1835	1885	Well repaired 2-20-29		
Total depth			1890'				

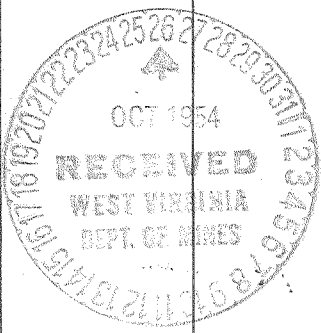

APR 22 1955

