

Latitude 38° 35'

Longitude 81° 20'

IVY ROBINSON

W.G. TETRICK

BETTIE N. BIRD

GARDNER & LITTLEPAGE

P.L. MULLINS

W. H. BIRD

New Location
Drill Deeper
Abandonment

NOV 8 1954

202 W
3.3 Q

Company UNITED FUEL GAS CO.
 Address CHARLESTON, W. VA.
 Farm P.L. MULLINS
 Tract _____ Acres 70 Lease No. 4586
 Well (Farm) No. _____ Serial No. 727
 Elevation (Spirit Level) 709.34'
 Quadrangle WALTON
 County KANAWHA District BIG SANDY
 Engineer Seybert R. Russell
 Engineer's Registration No. 2529
 File No. 74-71 Drawing No. _____
 Date 10-25-54 Scale 1" = 400'

STATE OF WEST VIRGINIA
DEPARTMENT OF MINES
OIL AND GAS DIVISION
CHARLESTON

WELL LOCATION MAP
FILE NO. KAN-1123-A

+ Denotes location of well on United States Topographic Maps, scale 1 to 62,500, latitude and longitude lines being represented by border lines as shown.

- Denotes one inch spaces on border line of original tracing.

6-6 220

P.L. MULLINS No. 727

U. F. G. Co.

KAN-1123-A



STATE OF WEST VIRGINIA
DEPARTMENT OF MINES
OIL AND GAS DIVISION

1574

WELL RECORD

Oil or Gas Well Gas
(KIND)


Quadrangle Walton
Permit No. 1234
Company UNITED FUEL GAS CO.
Address P.O. Box 1273, Charleston 25, W. Va.
Farm P. L. Mullins Acres 70
Location (waters) Gabe Creek
Well No. 727 Elev. 709.34'
District Big Sandy County Kanawha
The surface of tract is owned in fee by _____
Address _____
Mineral rights are owned by J. S. Gandee
Farmers & Citizens State Bank Address Clendenin, W. Va.
Drilling commenced 11-15-15
Drilling completed 12-16-15
Date Shot _____ From _____ To _____
With _____
Open Flow _____ /10ths Water in _____ Inch
64 /10ths Merc. in _____ 2 Inch
Volume 1,400,000 Cu. Ft.
Rock Pressure 400 lbs. 48 hrs.
Oil _____ bbls., 1st 24 hrs.
Fresh water 10 feet _____ feet
Salt water 1050' feet 1200' feet

| Casing and Tubing | Used in Drilling | Left in Well | Packers |
|-------------------|------------------|----------------|--------------------|
| Size | | | |
| 16 | | | Kind of Packer |
| 13 | | | <u>Parmaco</u> |
| 10 | | <u>39'6"</u> | Size of |
| 8 1/4 | <u>483'</u> | | <u>2x5-3/16x16</u> |
| 6 5/8 | | <u>1550'5"</u> | Depth set |
| 5 3/16 | | | <u>1602'</u> |
| 3 | | | Perf. top |
| 2 | | <u>1730'2"</u> | Perf. bottom |
| Liners Used | | | Perf. top |
| | | | Perf. bottom |

CASING CEMENTED _____ SIZE _____ No. Ft. _____ Date _____

COAL WAS ENCOUNTERED AT _____ FEET _____ INCHES
_____ FEET _____ INCHES FEET _____ INCHES
_____ FEET _____ INCHES FEET _____ INCHES

| Formation | Color | Hard or Soft | Top | Bottom | Oil, Gas or Water | Depth Found | Remarks |
|-------------------|-------|--------------|-------|--------|---|-------------|---|
| Soil | | | 0 | 3 | Hole full fresh water at 10' 5 bailers per hr. Salt water at 1050' & 1200' Reduced hole from 6-5/8" to 5-3/16" at 1577 1/2' | | |
| Gravel | | | 3 | 30 | | | |
| Red Rock | | | 30 | 40 | | | |
| Slate | | | 40 | 195 | | | |
| Sand | | | 195 | 332 | | | |
| Slate | | | 332 | 390 | | | |
| Little Dunkard | | | 390 | 435 | | | |
| Slate & Shells | | | 435 | 550 | | | |
| Big Dunkard | | | 550 | 625 | | | |
| Slate | | | 625 | 730 | | | |
| Gas Sand | | | 730 | 760 | | | |
| Slate | | | 760 | 950 | | | |
| 1st Salt Sand | | | 950 | 1460 | | | |
| Maxon Sand (None) | | | | | | | |
| Little Lime | | | 1460 | 1502 | | | |
| Pencil Cave | | | 1502 | 1506 | | | |
| Big Lime | | | 1506 | 1638 | | | |
| Big Injun | | | 1638 | 1674 | | | |
| Slate | | | 1674 | 1729 | | | |
| Total depth | | | 1729' | | | | |
| | | | | | | | Small show gas at 1610' Gas 1648' to 1658' |

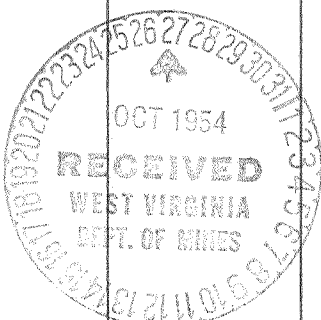

APR 22 1955

