

New Location
 Drill Deeper
 Abandonment

NOV 15 1954

4.31 W
 4.1 X

Company UNITED FUEL GAS CO.
 Address CHARLESTON, W. VA
 Farm F. W. CAMPBELL
 Tract _____ Acres 250 Lease No. 12054
 Well (Farm) No. _____ Serial No. 1124
 Elevation (Spirit Level) 620.00'
 Quadrangle WALTON
 County KANAWHA District BIG SANDY
 Engineer Seibert R. Russell
 Engineer's Registration No. 2529
 File No. 78-71 Drawing No. _____
 Date 10-26-54 Scale 1" = 400'

STATE OF WEST VIRGINIA
 DEPARTMENT OF MINES
 OIL AND GAS DIVISION
 CHARLESTON

WELL LOCATION MAP
 FILE NO. KAN-1127-A

+ Denotes location of well on United States Topographic Maps, scale 1 to 62,500, latitude and longitude lines being represented by border lines as shown.

- Denotes one inch spaces on border line of original tracing.

6-6 220



STATE OF WEST VIRGINIA
DEPARTMENT OF MINES
OIL AND GAS DIVISION

1970

WELL RECORD

Oil or Gas Well Gas
(KIND)

Quadrangle Walton
Permit No. 1177-A


Company UNITED FUEL GAS CO.
Address P.O. Box 1273, Charleston 25, W. Va.
Farm F. W. Campbell Acres 250
Location (waters) Big Sandy Creek
Well No. 1124 Elev. 620'
District Big Sandy County Karawha
The surface of tract is owned in fee by _____
Address _____
Mineral rights are owned by M. C. Campbell
Box 14 Address Clendenin, W. Va.
Drilling commenced 2-12-20
Drilling completed 3-23-20
Date Shot _____ From _____ To _____
With _____
Open Flow 18 /10ths Water in 6-5/8 Inch
_____/10ths Merc. in _____ Inch
Volume 2,100,000 Cu. Ft.
Rock Pressure 310 lbs. _____ hrs.
Oil _____ bbls., 1st 24 hrs.
Fresh water _____ feet _____ feet
Salt water 925 feet _____ feet

Casing and Tubing	Used in Drilling	Left in Well	Packers
Size			
16			Kind of Packer <u>Anchor</u>
13			
10		<u>20'3"</u>	Size of <u>2x5-3/16x16</u>
8 1/4	<u>380'</u>		Depth set <u>1511'</u>
6 5/8		<u>1440'</u>	
5 3/16			Perf. top _____ Perf. bottom _____
3			
2		<u>1618'</u>	
Liners Used			Perf. top _____ Perf. bottom _____

CASING CEMENTED _____ SIZE _____ No. Ft. _____ Date _____

COAL WAS ENCOUNTERED AT _____ FEET _____ INCHES
_____ FEET _____ INCHES _____ FEET _____ INCHES
_____ FEET _____ INCHES _____ FEET _____ INCHES

Formation	Color	Hard or Soft	Top	Bottom	Oil, Gas or Water	Depth Found	Remarks
Clay			0	7			
Sand			7	40			
Slate			40	43			
Sand			43	60			
Slate & Shells			60	80			
Sand			80	150			
Slate & Shells			150	170			
Sand			170	365			
Slate			365	376			
Sandy Lime			376	388			
Slate & Shells			388	420			
Sand			420	490			
Slate			490	550			
Hard Lime			550	580			
Sand			580	615			
Slate & Shells			615	670			
Sand			670	725			
Slate & Shells			725	820			
Salt Sand			820	1250			
Show Gas			830				
Show oil			840				
Water			925				
Black Lime			1250	1277			
Maxon Sand			1277	1371			
Little Lime			1371	1398			
Pencil Cave			1398	1416			
Big Lime			1416	1528			
Show oil			1471				Show oil 1471 Hole reduced 1476 Gas 1549, 1556', 1558', 1562'
Injun			1528	1562			
Slate & Shells			1562	1603			
Total depth			1603'				

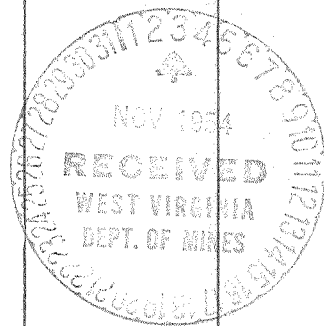

OCT 6 1955

