

New Location
 Drill Deeper
 Abandonment

NOV 29 1954

Company	UNITED FUEL GAS CO.
Address	CHARLESTON, W. VA.
Farm	U. F. G. CO. FEE
Tract	Acres 776 Deed 27461
Well (Farm) No.	1 Serial No. 3325
Elevation (Spirit Level)	992.8
Quadrangle	CLENDENIN
County	KANAWHA District BIG SANDY
Engineer	<i>Stephen R. Howell</i>
Engineer's Registration No.	2529
File No.	72-61 Drawing No.
Date	11-9-54 Scale 1"=400'

STATE OF WEST VIRGINIA
 DEPARTMENT OF MINES
 OIL AND GAS DIVISION
 CHARLESTON

WELL LOCATION MAP
 FILE NO. **KAN-1146-A**

+ Denotes location of well on United States Topographic Maps, scale 1 to 62,500, latitude and longitude lines being represented by border lines as shown.
 - Denotes one inch spaces on border line of original tracing.



STATE OF WEST VIRGINIA
DEPARTMENT OF MINES
OIL AND GAS DIVISION

1903

WELL RECORD

Oil or Gas Well Gas & Oil
(KIND)


Quadrangle Clendenin
Permit No. 1146A

Company UNITED FUEL GAS CO.
Address P.O. Box 1273, Charleston 25, W. Va.
Farm J. C. Ross Acres 776
Location (waters) Indian Creek
Well No. 3325 Elev. 992.8'
District Big Sandy County Kanawha
The surface of tract is owned in fee by United Fuel Gas Co.
Address _____
Mineral rights are owned by _____
Address _____
Drilling commenced 1-25-17
Drilling completed 3-23-17
Date Shot 4-2-17 From _____ To _____
With 60 qts
Open Flow /10ths Water in _____ Inch
/10ths Merc. in _____ Inch
Volume _____ Cu. Ft.
Rock Pressure _____ lbs. _____ hrs.
Oil 1/2 bbls., 1st 24 hrs.
Fresh water _____ feet _____ feet
Salt water _____ feet _____ feet

Casing and Tubing	Used in Drilling	Left in Well	Packers
Size			Kind of Packer
16			
13			
10			Size of
8 1/2	365'		
6 5/8		1533'	Depth set
5 3/16			
3			Perf. top
2			Perf. bottom
Liners Used			Perf. top
			Perf. bottom

CASING CEMENTED _____ SIZE _____ No. Ft. _____ Date _____
COAL WAS ENCOUNTERED AT _____ FEET _____ INCHES
_____ FEET _____ INCHES _____ FEET _____ INCHES
_____ FEET _____ INCHES _____ FEET _____ INCHES

Formation	Color	Hard or Soft	Top	Bottom	Oil, Gas or Water	Depth Found	Remarks
Clay			8		Well Repaired June 1931		
Sand & Slate			8	815			
Salt Sand			815	1338			
Slate			1338	1346			
Lime			1346	1355			
Red Rock			1355	1362			
Lime & Slate			1362	1440			
Maxon			1440	1477			
Little Lime			1477	1509			
Pencil Cave			1509	1531			
Big Lime			1531	1681			
Dark Sand S.I.			1681	1693			
Slate & Red Rock			1693	1741			
Weir			1741	1950			
Black Slate			1950	1958			
Total depth			1958'				

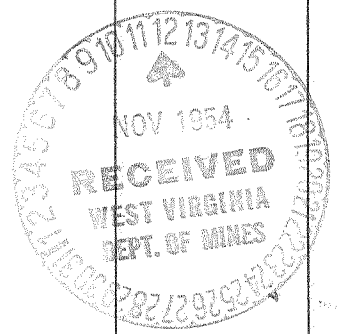

JUN 17 1955

