

New Location
 Drill Deeper
 Abandonment

Company UNITED FUEL GAS CO.
 Address CHARLESTON, W. VA.
 Farm ROBSON & PRICHARD
 Tract _____ Acres 1305.38 Lease No. 3025
 Well (Farm) No. _____ Serial No. 1569
 Elevation (Spirit Level) 850.
 Quadrangle MONTGOMERY
 County KANAWHA District CABIN CK.
 Engineer Seibert R. Jewell
 Engineer's Registration No. 2529
 File No. 74-49 Drawing No. _____
 Date 11-12-54 Scale 1"=400'

STATE OF WEST VIRGINIA
 DEPARTMENT OF MINES
 OIL AND GAS DIVISION
 CHARLESTON

WELL LOCATION MAP
 FILE NO. KAN-1147-A

+ Denotes location of well on United States Topographic Maps, scale 1 to 62,500, latitude and longitude lines being represented by border lines as shown.

- Denotes one inch spaces on border line of original tracing.



STATE OF WEST VIRGINIA
DEPARTMENT OF MINES
OIL AND GAS DIVISION

1411

Quadrangle Montgomery

Permit No. 1147A

WELL RECORD

Oil or Gas Well Gas
(KIND)

Company UNITED FUEL GAS CO.

Address P.O. Box 1273, Charleston 25, W. Va.

Farm Robson & Prichard Acres 1305.38'

Location (waters) Paint Ck.

Well No. 1569 Elev. 850'

District Cabin Creek County Kanawha

The surface of tract is owned in fee by _____
Address _____

Mineral rights are owned by H. A. Robson Estate Inc. et al
Address Huntington, W. Va.

Drilling commenced 1-4-26

Drilling completed 3-27-26

Date Shot 3-29-26 From _____ To _____

With 80 cts.

Open Flow 9 /10ths Water in _____ Inch
1 /10ths Merc. in _____ Inch

Volume 132,000 Cu. Ft.

Rock Pressure 476 lbs. _____ hrs.

Oil _____ bbls., 1st 24 hrs.

Fresh water _____ feet _____ feet

Salt water _____ feet _____ feet

Casing and Tubing	Used in Drilling	Left in Well	Packers
Size			
16			Kind of Packer
13			Anchor
10		<u>446</u>	Size of
8 1/4	<u>1153</u>		<u>3x6-5/8x16</u>
6 1/2		<u>1712</u>	Depth set
5 3/16			<u>2081</u>
3		<u>2450</u>	Perf. top
2			Perf. bottom
Liners Used			Perf. top
			Perf. bottom


CASING CEMENTED _____ SIZE _____ No. Ft. _____ Date _____

COAL WAS ENCOUNTERED AT 60 FEET 60 INCHES

_____ FEET _____ INCHES _____ FEET _____ INCHES

_____ FEET _____ INCHES _____ FEET _____ INCHES

Formation	Color	Hard or Soft	Top	Bottom	Oil, Gas or Water	Depth Found	Remarks
Clay			0	20			
Slate			20	60	Gas in Weir		
Coal			60	65			
Slate & Shells			65	410	Gas 2347-2351		
Sand			410	426	Gas 2360-2365		
Slate & Shells			426	490			
Lime			490	521			
Slate & Shells			521	622			
Sand			622	757			
Slate & Shells			757	840			
Salt Sand			840	1103			
Slate & Shells			1103	1190			
Red Rock			1190	1230			
Sand			1230	1278			
Red Rock & Shells			1278	1505			
Maxon Sand			1505	1592			
Little Lime			1592	1625			
Pencil Cave			1625	1643			
White Lime Shell			1643	1653			
Pencil Cave			1653	1665			
Big Lime			1665	1885			
Big Injun			1885	1930			
Slate			1930	1938			
Weir Sand			1938	2114			
Lime			2114	2136			
Slate			2136	2336			
Berea Sand			2336	2376			
Black Lime			2376	2423			
Total depth			2423'				

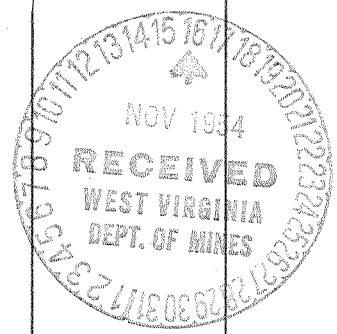

AUG 12 1955

