

Latitude 78° 15'

Longitude 81° 25'

New Location...
 Drill Deeper.....
 Abandonment.....

JAN 3 1955

0.4 W
 2.47 Q

Company UNITED FUEL GAS CO.
 Address CHARLESTON, W. VA.
 Farm NELLIE B. TOMPKINS
 Tract _____ Acres 1355 1/2 Lease No. 14120
 Well (Farm) No. 9 Serial No. 1777
 Elevation (Spirit Level) 660
 Quadrangle MONTGOMERY
 County KANAWHA District CABIN CR.
 Engineer Leah R. Howell
 Engineer's Registration No. 2529
 File No. 72-49 Drawing No. _____
 Date 11-17-54 Scale 1"=1320'

STATE OF WEST VIRGINIA
 DEPARTMENT OF MINES
 OIL AND GAS DIVISION
 CHARLESTON

WELL LOCATION MAP
 FILE NO. KAN-1158-A

+ Denotes location of well on United States Topographic Maps, scale 1 to 62,500, latitude and longitude lines being represented by border lines as shown.

- Denotes one inch spaces on border line of original tracing.

6-6 24

NELLIE B. TOMPKINS No. 9 (1777) - U. F. G. Co. - KAN-1158-A



STATE OF WEST VIRGINIA
DEPARTMENT OF MINES
OIL AND GAS DIVISION

1915

Quadrangle Montgomery

WELL RECORD

Permit No. 1587

Oil or Gas Well Gas



(KIND)

Company United fuel Gas Co.
Address P.O. Box 1273, Charleston 25, W. Va.
Farm Nellie B. Thompkins Acres 1355 1/2
Location (waters) Kellys Creek
Well No. 1777 Elev. 660'
District Cabin Creek County Kanawha
The surface of tract is owned in fee by _____
Address _____
Mineral rights are owned by Dorrit V. Thompkins
4 Wrangler Rd. Rolling hills Palos Verdes, Calif
Drilling commenced _____
Drilling completed 1-12-27
Date Shot 1-13-27 From _____ To _____
With 30 qts.
Open Flow 16 /10ths Water in 2 Inch
_____/10ths Merc. in _____ Inch
Volume 169,000 Cu. Ft.
Rock Pressure 122 lbs. 12 hrs.
Oil _____ bbls., 1st 24 hrs.
Fresh water 278 feet
Salt water _____ feet

Casing and Tubing	Used in Drilling	Left in Well	Packers
Size			
16			Kind of Packer <u>ONS Anchor</u>
13			
10		<u>266'</u>	Size of <u>3x5-3/16x16</u>
8 1/4	<u>1066</u>		Depth set <u>1743</u>
6 5/8		<u>1518'</u>	
5 3/16			
3		<u>1921</u>	Perf. top
2			Perf. bottom
Liners Used			Perf. top
			Perf. bottom

CASING CEMENTED _____ SIZE _____ No. Ft. _____ Date _____
COAL WAS ENCOUNTERED AT 58 FEET 48 INCHES
____ FEET _____ INCHES FEET _____ INCHES
____ FEET _____ INCHES FEET _____ INCHES

Formation	Color	Hard or Soft	Top	Bottom	Oil, Gas or Water	Depth Found	Remarks
Soil			0	14	Water hole full	278'	
Gravel			14	16	Gas	1590'	
Sand			16	30	Hole reduced	1710'	
Slate			30	50			
Sand			50	58			
Coal			58	62			
Lime			62	70	Gas	1770-1795	
Slate			70	140			
Sand			140	165			
Slate			165	215			
Sand			215	275			
Slate			275	295			
Sand			295	340			
Slate			340	395			
Grampus			395	465			
Coal & Slate			465	470			
Slate Sand			470	923			
Slate Break			922	926			
Sand			926	956			
Slate			956	1055			
Lime			1055	1060			
Red Rock			1060	1095			
Slate			1095	1129			
Red Rock			1129	1195			
Slate & Shells			1195	1280			
Maxon Sand			1280	1355			
Slate			1355	1360			
Little Lime			1360	1406			
Pencil Cave			1406	1426			
Big Lime			1426	1625			
Red Rock			1625	1630			
Big Injun			1630	1672			
Slate			1672	1705			
Weir Sand			1705	1865			
Slate			1865	1900			
Total depth			1900'				

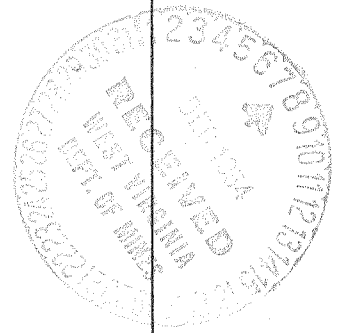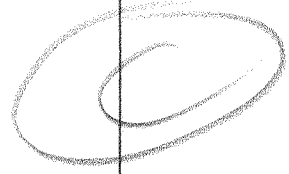

AUG 12 1955

