

Company UNITED FUEL GAS CO.

Address CHARLESTON, W. VA.

Farm LOUISA D. UPDEGRAFF

Tract \_\_\_\_\_ Acres 2080 Lease No. 4615

Well (Farm) No. 2 Serial No. 1501

Elevation (Spirit Level) 1255.0'

Quadrangle CLENDENIN

County KANAWHA District BIG SANDY

Engineer Prof. E. J. ...

Engineer's Registration No. 669

File No. 78-63 Drawing No. \_\_\_\_\_

Date 12-29-54 Scale 1"=1320'

STATE OF WEST VIRGINIA  
DEPARTMENT OF MINES  
OIL AND GAS DIVISION  
CHARLESTON

WELL LOCATION MAP  
FILE NO. KAN-1163-A

+ Denotes location of well on United States Topographic Maps, scale 1 to 62,500, latitude and longitude lines being represented by border lines as shown.

- Denotes one inch spaces on border line of original tracing.

66 220

LOUISA D. UPDEGRAFF No. 2 (1501) - U, F, G, Co. - KAN-1163-A



STATE OF WEST VIRGINIA  
DEPARTMENT OF MINES  
OIL AND GAS DIVISION

1916

Clendenin

Quadrangle

Permit No. 1163A

WELL RECORD

Oil or Gas Well Gas  
(KIND)

Company UNITED FUEL GAS CO.  
Address P.O. Box 1273, Charleston 25, W. Va.  
Farm Louisa D. Updegroff Acres 2080  
Location (waters) Falling Rock Creek  
Well No. 1301 Elev. 1255'  
District Big Sandy County Kanawha  
The surface of tract is owned in fee by  
Address Louise Frackelton, et al  
Mineral rights are owned by 129 Laurel Drive Altadena, Calif.  
Address  
Drilling commenced 9-18-25  
Drilling completed 12-25-25  
Date Shot 12-23-25 From To  
With 15 qts.  
Open Flow 45 /10ths Water in 2 Inch  
/10ths Merc. in Inch  
Volume 319,680 Cu. Ft.  
Rock Pressure 320 lbs. hrs.  
Oil bbls., 1st 24 hrs.  
Fresh water 1335' feet 1380', 1570' feet  
Salt water feet feet

Casing and Tubing	Used in Drilling	Left in Well	Packers
Size			Kind of Packer
16			Anchor
13			Size of
10	537'		5-3/16x3
8 1/4		1769'	Depth set
6 5/8		1929'	1995'
5 3/16		2140' 8"	Perf. top
3			Perf. bottom
2			Perf. top
Liners Used			Perf. bottom


CASING CEMENTED SIZE No. Ft. Date  
COAL WAS ENCOUNTERED AT 121 FEET 36 INCHES  
142 FEET 48 INCHES FEET INCHES  
FEET INCHES FEET INCHES

Formation	Color	Hard or Soft	Top	Bottom	Oil, Gas or Water	Depth Found	Remarks
Surface			0	16			
Sand			16	36			
Lime			36	46			
Slate			46	61			
Lime			61	121			
Coal			121	124			
Sand			124	142			
Coal			142	146			
Lime			146	151			
Slate			151	175			
Sand			175	370			
Slate			370	400			
Sand			400	550			
Slate			550	620			
Sand			620	800			
Slate			800	988			
Gas Sand			988	1000			
Slate & Shell			1000	1100			
Slate & Shell			1605	1656			
Red Rock			1656	1668			
Lime			1668	1672			
Slate & Shell			1672	1792			
Maxon			1792	1842			
Slate			1842	1845			
Little Lime			1845	1875			
Pencil Cave			1875	1883			
Lime			1883	1890			
Pencil Cave			1890	1897			
Big Lime			1897	2015			
Keener			2015	2063			
Injun			2063	2095			
Slate & Shell			2095	2466			
Sand Berea			2466	2480			
Slate & Shell			2480	2600			
Total depth			2600'				



Hole full water 1335'  
Water 1380'  
Water 1570'  
Small show gas 1925'  
Gas 2025-2029'  
Show oil 2029-2031'  
Gas 2031-2040'  
Show oil in injun sand

Hole filled up to 2108'

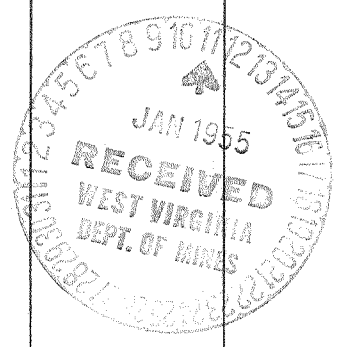

AUG 12 1955

