

New Location...   
 Drill Deeper.....   
 Abandonment.....

FEB 21 1955

Company UNITED FUEL GAS CO.  
 Address CHARLESTON, W.VA.  
 Farm SUNDAY CREEK CO.  
 Tract \_\_\_\_\_ Acres 14.128 Lease No. 9279  
 Well (Farm) No. 2 Serial No. 913  
 Elevation (Spirit Level) 1331.8'  
 Quadrangle MONTGOMERY  
 County KANAWHA District CABIN CREEK  
 Engineer Leahbert R. Farrell  
 Engineer's Registration No. 2529 (W.VA.)  
 File No. 72-51 Drawing No. \_\_\_\_\_  
 Date 12-21-54 Scale 1"=1320'

STATE OF WEST VIRGINIA  
 DEPARTMENT OF MINES  
 OIL AND GAS DIVISION  
 CHARLESTON

WELL LOCATION MAP  
 FILE NO. KAN-1164-B

+ Denotes location of well on United States Topographic Maps, scale 1 to 62,500, latitude and longitude lines being represented by border lines as shown.  
 - Denotes one inch spaces on border line of original tracing.

6-6-241



STATE OF WEST VIRGINIA  
DEPARTMENT OF MINES  
OIL AND GAS DIVISION

1905

Quadrangle Montgomery

Permit No. 1164-A

WELL RECORD

Oil or Gas Well Gas  
(KIND)

Company UNITED FUEL GAS CO.  
Address P.O. Box 1273, Charleston 25, W. Va.  
Farm Sunday Creek Company Acres 14,128  
Location (waters) Kelley Creek  
Well No. 913 Elev. 1331.8'  
District Cabin Creek County Kanawha

The surface of tract is owned in fee by  
Address

Mineral rights are owned by Kanawha & Hocking Coal & Coke Co., 111 Capitol St. address Charleston, W. Va.

Drilling commenced 5-2-17

Drilling completed 7-23-17

Date Shot 7-24-17 From 2353 To 2409

With 80 qts.

Open Flow 4.8 /10ths Water in 3" Inch

Volume 2,700,000 Cu. Ft.

Rock Pressure 410 lbs. hrs.

Oil \_\_\_\_\_ bbls., 1st 24 hrs.

Fresh water \_\_\_\_\_ feet


Salt water \_\_\_\_\_ feet

| Casing and Tubing | Used in Drilling | Left in Well | Packers         |
|-------------------|------------------|--------------|-----------------|
| Size              |                  |              |                 |
| 16                |                  | 22'          | Kind of Packer  |
| 18                |                  |              | <u>Anchor</u>   |
| 10                |                  | 705'         | Size of         |
| 8 1/4             | 1802'            |              | <u>3x6-5/8"</u> |
| 6 3/4             |                  | 2063'        | Depth set       |
| 5 3/16            |                  |              | <u>2391'</u>    |
| 3                 |                  | 2496'        | Perf. top       |
| 2                 |                  |              | Perf. bottom    |
| Liners Used       |                  |              | Perf. top       |
|                   |                  |              | Perf. bottom    |

CASING CEMENTED \_\_\_\_\_ SIZE \_\_\_\_\_ No. Ft. \_\_\_\_\_ Date \_\_\_\_\_

COAL WAS ENCOUNTERED AT 25 FEET 84 INCHES  
155 FEET 60 INCHES 300 FEET 60 INCHES  
590 FEET 60 INCHES FEET INCHES

| Formation   | Color | Hard or Soft | Top   | Bottom | Oil, Gas or Water | Depth Found | Remarks |
|-------------|-------|--------------|-------|--------|-------------------|-------------|---------|
| Coal        |       |              | 25    | 32     |                   |             |         |
| Coal        |       |              | 155   | 160    |                   |             |         |
| Coal        |       |              | 300   | 305    |                   |             |         |
| Coal        |       |              | 590   | 595    |                   |             |         |
| Salt Sand   |       |              | 1080  | 1330   |                   |             |         |
| Slate       |       |              | 1330  | 1390   |                   |             |         |
| Salt Sand   |       |              | 1390  | 1605   |                   |             |         |
| Maxon Sand  |       |              | 1890  | 1905   |                   |             |         |
| Slate       |       |              | 1905  | 1950   |                   |             |         |
| Black Slate |       |              | 1950  | 1960   |                   |             |         |
| Little Lime |       |              | 1960  | 1990   |                   |             |         |
| Line Shells |       |              | 1990  | 2010   |                   |             |         |
| Pencil Cave |       |              | 2010  | 2020   |                   |             |         |
| Big Lime    |       |              | 2020  | 2207   |                   |             |         |
| Big Injun   |       |              | 2207  | 2267   |                   |             |         |
| Weir Sand   |       |              | 2267  | 2456   |                   |             |         |
| Total depth |       |              | 2496' |        |                   |             |         |

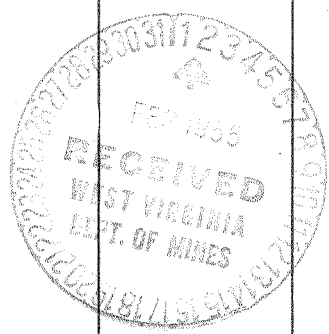

JUN 17 1955

