

New Location...
 Drill Deeper.....
 Abandonment.....

Company UNITED FUEL GAS CO.
 Address CHARLESTON, W.VA.
 Farm SUNDAY CREEK CO.
 Tract _____ Acres 14,128 Lease No. 9279
 Well (Farm) No. 37 Serial No. 1158
 Elevation (Spirit Level) 723.54'
 Quadrangle MONTGOMERY
 County KANAWHA District CABIN CREEK
 Engineer Seibert K. Jewell
 Engineer's Registration No. 2529
 File No. 68-51 Drawing No. _____
 Date 12-21-54 Scale 1"=1320'

STATE OF WEST VIRGINIA
 DEPARTMENT OF MINES
 OIL AND GAS DIVISION
 CHARLESTON

WELL LOCATION MAP
 FILE NO. KAN-1165-A

+ Denotes location of well on United States Topographic Maps, scale 1 to 62,500, latitude and longitude lines being represented by border lines as shown.

- Denotes one inch spaces on border line of original tracing.

6-6 241



Daniel Dawson
Copy
Keep clean

1914

STATE OF WEST VIRGINIA
DEPARTMENT OF MINES
OIL AND GAS DIVISION

WELL RECORD

Oil or Gas Well Gas
(KIND)

Quadrangle Montgomery
Permit No. 1165 A

Company UNITED FUEL GAS CO.
Address P.O. Box 1273, Charleston 25, W. Va.
Farm Sunday Creek Coal & Land Co. Acres 14,128
Location (waters) Witchers Creek
Well No. 1158 Elev. 723.54'
District Cabin Creek County Kanawha
The surface of tract is owned in fee by _____
Address _____
Mineral rights are owned by Kanawha & Hocking Coal & Coke Co. 111 Capitol St. Address Charleston, W. Va.
Drilling commenced June 7, 1920
Drilling completed July 28, 1920
Date Shot _____ From _____ To _____
With _____


Open Flow 32 /10ths Water in _____ Inch
3 /10ths Merc. in _____ Inch
Volume 1,980,000 Cu. Ft.
Rock Pressure 415 lbs. _____ hrs.
Oil _____ bbls., 1st 24 hrs.
Fresh water _____ feet _____ feet
Salt water _____ feet _____ feet

Casing and Tubing	Used in Drilling	Left in Well	Packers
Size			
16			Kind of Packer <u>Anchor</u>
18		<u>30'</u>	<u>Parm.</u>
10			Size of <u>6-5/8x3x16"</u>
8 3/4		<u>332'</u>	Depth set _____
6 3/4		<u>1323'</u>	<u>1431'</u>
5 3/16		<u>1400'</u>	
3			Perf. top _____
2			Perf. bottom _____
Liners Used			Perf. top _____
			Perf. bottom _____

CASING CEMENTED _____ SIZE _____ No. Ft. _____ Date _____
COAL WAS ENCOUNTERED AT 45 FEET 60 INCHES
210 FEET 60 INCHES 330 FEET 24 INCHES
_____ FEET _____ INCHES _____ FEET _____ INCHES

Formation	Color	Hard or Soft	Top	Bottom	Oil, Gas or Water	Depth Found	Remarks
Coal			45	50			
Slate & Shells			50	210			
Coal			210	215			
Coal			330	332			
Sand			1040	1145			
Slate			1145	1150			
Sand			1150	1190			
Slate			1190	1232			
Lime			1232	1270			
Slate			1270	1275			
Lime			1275	1290			
Slate			1290	1296			
Lime			1296	1306			
Slate			1306	1313			
Big Lime			1313	1486			
Big Injun			1486	1540			
Slate & Shells			1540	1605			
Sand Weir			1605	1780			
Slate			1780	1786			
Total depth			1786'				

Gas 1385-1386', 1472-1474', 1605-1611', 1617-1621', 1627-1631', 1645-1649', 1663-1670', 1700-1703'.

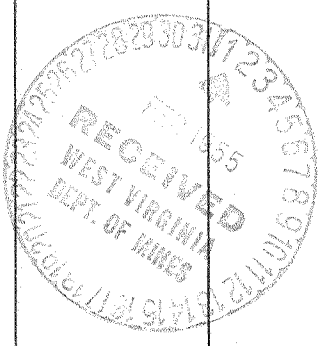

AUG 12 1955

