

Latitude 38° 15'

Longitude 81° 30'

New Location..
 Drill Deeper.....
 Abandonment.....

APR 18 1955

118 W
 110 S

Company UNITED FUEL GAS CO.
 Address CHARLESTON, W. VA.
 Farm SALLIE P. SNEAD
 Tract _____ Acres 645 Lease No. 19316
 Well (Farm) No. _____ Serial No. 1585
 Elevation (Spirit Level) 1317.5
 Quadrangle PEYTONA
 County KANAWHA District CABIN CR.
 Engineer Seibert R. Farrell
 Engineer's Registration No. 2529
 File No. 66-51 Drawing No. _____
 Date 3-28-55 Scale 1"=1320'

STATE OF WEST VIRGINIA
 DEPARTMENT OF MINES
 OIL AND GAS DIVISION
 CHARLESTON

WELL LOCATION MAP
 FILE NO. KAN-1176-A

+ Denotes location of well on United States Topographic Maps, scale 1 to 62,500, latitude and longitude lines being represented by border lines as shown.

- Denotes one inch spaces on border line of original tracing.

6-6 214

SALLIE P. SNEAD No. 1585 - U, F, G, Co. - KAN-1176-A



STATE OF WEST VIRGINIA
DEPARTMENT OF MINES
OIL AND GAS DIVISION

1913

Quadrangle Peytona

WELL RECORD

Permit No. 176A

Oil or Gas Well Gas
(KIND)

Company UNITED FUEL GAS COMPANY
Address P.O. Box 1273, Charleston 25, W. Va.
Farm Sallie P. Snead Acres 645
Location (waters) Witchers Creek
Well No. 1585 Elev. 1317.5'
District Cabin Creek County Kanawha
The surface of tract is owned in fee by _____
Address _____
Mineral rights are owned by William F. Peters, Jr.
Acting Trustee, 426 - 48th St. West Palm Beach,
Address Fla.
Drilling commenced 2-23-26
Drilling completed 4-20-26
Date Shot _____ From _____ To _____
With _____


Casing and Tubing	Used in Drilling	Left in Well	Packers
Size			
16			Kind of Packer
18			Anchor
10			Size of
8 1/4		970'	3x6-5/8x16
6 5/8		1900'	Depth set
5 3/16			1777'
3		2300'	Perf. top
2			Perf. bottom
Liners Used			Perf. top
			Perf. bottom

Open Flow 26 /10ths Water in _____ 3 Inch
/10ths Merc. in _____ Inch
Volume 550,000 Cu. Ft.
Rock Pressure 330 lbs. _____ hrs.
Oil _____ bbls., 1st 24 hrs.
Fresh water 430' feet _____ feet
Salt water 1350' feet _____ feet

CASING CEMENTED _____ SIZE _____ No. Ft. _____ Date _____

COAL WAS ENCOUNTERED AT 290 FEET 24 INCHES
430 FEET 48 INCHES 640 FEET 24 INCHES
_____ FEET _____ INCHES _____ FEET _____ INCHES

Formation	Color	Hard or Soft	Top	Bottom	Oil, Gas or Water	Depth Found	Remarks
Sand			0	8			
Lime			8	110			
Slate & Shells			110	140			
Sand			140	215			
Slate & Shells			215	290			
Coal			290	292			
Lime			292	305			
Sand			305	330			
Slate			330	400			
Lime			400	430			
Coal			430	434			
Slate & Shells			434	490			
Sand			490	540			
Lime			540	585			
Slate & Shells			585	640			
Coal			640	642	Gas 1966-1969'		
Sand			642	685			
Slate & Shells			685	735	Gas 2207-2211'		
Sand			735	765			
Slate & Shells			765	815			
Lime			815	885			
Slate & Shells			885	1000			
Sand			1000	1040			
Slate & Shells			1040	1070			
Salt Sand			1070	1120			
Slate			1120	1145			
Salt Sand			1145	1415			
Slate & Shells			1415	1470			
Salt Sand			1470	1630			
Slate			1630	1635			
Red Rock			1635	1640			
Slate & Shells			1640	1670			
Red Rock			1670	1673			
Slate & Shells			1673	1715			
Red Rock			1715	1721			
Maxon Sand			1721	1775			
Lime			1775	1785			
Pencil Cave			1785	1787			
Little Lime			1787	1812			
Shells			1812	1830			

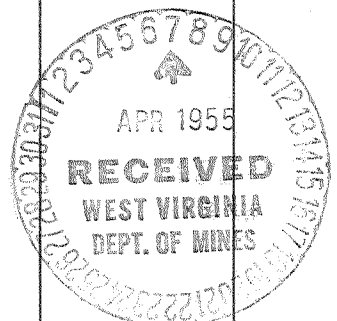

Formation	Color	Hard or Soft	Top	Bottom	Oil, Gas or Water	Depth Found	Remarks
Lime			1830	1840			
Slate			1840	1849			
Pencil Cave			1849	1851			
Big Lime			1851	1991			
Big Injun			1991	2065			
Slate & Shells			2065	2095			
Weir Sand			2095	2275			
Slate			2275	2284			
Total depth			2284'				

Date April 6, 1955

APPROVED UNITED FUEL GAS COMPANY, Owner

By S. R. Ferrell
(Title)

Mgr. Civil Engineering Dept.