

New Location...
 Drill Deeper.....
 Abandonment.....

JUN 6 1955

Company THE CHARTIERS OIL CO.
 Address PITTSBURG, PA.
 Farm MARY S. PAULEY
 Tract _____ Acres 116 Lease No. _____
 Well (Farm) No. 1 Serial No. _____
 Elevation (Spirit Level) 655
 Quadrangle KENNA
 County KANAWHA District POCA
 Engineer G. C. Ewing
 Engineer's Registration No. 4309
 File No. _____ Drawing No. _____
 Date 9-12-42 Scale 1" = 600'

STATE OF WEST VIRGINIA
 DEPARTMENT OF MINES
 OIL AND GAS DIVISION
 CHARLESTON

WELL LOCATION MAP

FILE NO. KAN-1178-A
 NOW:- POCA FORK OIL & GAS COMPANY
CLENDENIN, W. VA.
 + Denotes location of well on United States
 Topographic Maps, scale 1 to 62,500, lat-
 itude and longitude lines being represented
 by border lines as shown.

- Denotes one inch spaces on border line
 of original tracing.

6-6 0

MARY S. PAULEY No. 1 - THE CHARTIERS OIL CO. - KAN-1178-A

STATE OF WEST VIRGINIA
DEPARTMENT OF MINES
OIL AND GAS DIVISION

7001

WELL RECORD

Lease No. 133

Oil or Gas Well Oil
(Kind)


Permit No. Kan-1178-A

Company The Chartiers Oil Company
Address 1514 Farmers Bk. Bldg., Pittsburgh 22, Pa.
Farm Mary S. Pauley, et al Acres 116
Location (waters) Poca River
Well No. 1 Elev. 655
District Poca County Kanawha
The surface of tract is owned in fee by Mary S. Pauley
Heirs Address Sisemville, W. Va.
Mineral rights are owned by Mora J. Pauley, do.
Charlotte H. Dudley Address Wilmington, Del.
Drilling commenced Nov. 21, 1927
Drilling completed Dec. 17, 1927
Date shot _____ Depth of shot _____
Open Flow /10ths Water in _____ Inch
/10ths Merc. in _____ Inch
Volume _____ Cu. Ft.
Rock Pressure _____ lbs. _____ hrs.
Oil 15 bbls., 1st 24 hrs.
Fresh water 86 feet _____ feet
Salt water 683 - 1176 feet 1199 feet

Casing and Tubing	Used in Drilling	Left in Well	Packers
Size			
16			Kind of Packer
13	<u>Wood</u>	<u>12</u>	
10	<u>3 1/2</u>	<u>168</u>	Size of
8 1/4	<u>2 1/2</u>	<u>693</u>	
6 5/8	<u>1 7/8</u>	<u>1529</u>	Depth set
5 3/16			
3			Perf. top
2		<u>1647</u>	Perf. bottom
Liners Used			Perf. top
			Perf. bottom

CASING CEMENTED _____ SIZE _____ No. FT. _____ Date _____
COAL WAS ENCOUNTERED AT _____ FEET _____ INCHES
_____ FEET _____ INCHES _____ FEET _____ INCHES
_____ FEET _____ INCHES _____ FEET _____ INCHES

Formation	Color	Hard or Soft	Top	Bottom	Oil Gas or Water	Depth Found	Remarks
Sand, Slate & Shells			0	50			
Sand			50	66			
Slate			66	85			
Rock	Red		85	114	Water	86	Hole full.
Slate			114	150			
Rock	Red		150	158			
Line			158	164			
Rock	Red		164	249			
Line			249	272			
Rock & Shells	Red		272	337			
Sand			337	349			
Rock	Red		349	379			
Slate & Shells			379	502			
Little Dunkard Sand			502	524			
Slate			524	547			
Big Dunkard Sand			547	600			
Slate			600	610			
Sand			610	670			
Coal			670	686	Water	683	3 bailers per hour.
Sand			686	702			
Slate & Shells			702	756			
Gas Sand			756	792			
Slate			792	796			
Sand			796	820			
Slate & Shells			820	865			
Sand			865	892			
Slate & Shells			892	1080			
Slate	Black		1080	1103			
Sand Shell		Very Hard	1103	1108			
Slate	Black		1108	1141			
Salt Sand			1141	1450			
					Oil	1156	Show. 1 hour test, 1 qt. oil in bailer.
					Water	1176	2 bailers per hour.
					Water	1199	Hole full.

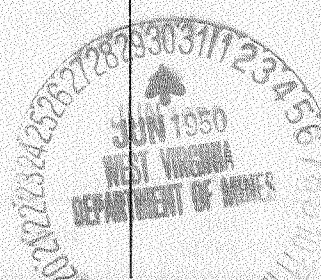

MAR 20 1928

Formation	Color	Hard or Soft	Top	Bottom	Oil, Gas or Water	Depth Found	Remarks
Maxon Sand			1450	1493			
Little Line			1493	1516			
Slate (Break)			1516	1518			
Line Shell			1518	1520			
Pencil Cave	Pink		1520	1527			Very bad cave.
Big Line			1527	1612			
Gas & Oil Pay			1612	1617			
Total Depth:				1620			Quit in Big Line.

Date June 20th, 1950

APPROVED THE CHARITIES OIL COMPANY, Owner

By John Brown Treasurer
(Title)