

New Location...
 Drill Deeper.....
 Abandonment.....

Company	UNITED FUEL GAS CO.
Address	CHARLESTON, W.VA.
Farm	W. D. LEWIS
Tract	Acres 1598 Lease No. 49137
Well (Farm) No.	Serial No. 6874
Elevation (Spirit Level)	809.77
Quadrangle	CHARLESTON
County	KANAWHA District MALDEN
Engineer	Paul E. ...
Engineer's Registration No.	669
File No.	66-55 Drawing No.
Date	6-8-55 Scale 1"=660'

STATE OF WEST VIRGINIA
 DEPARTMENT OF MINES
 OIL AND GAS DIVISION
 CHARLESTON

WELL LOCATION MAP
 FILE NO. KAN-1182-A

+ Denotes location of well on United States Topographic Maps, scale 1 to 62,500, latitude and longitude lines being represented by border lines as shown.

- Denotes one inch spaces on border line of original tracing.

W. D. LEWIS No. 6874 — U. F. G. Co. — KAN-1182-A



STATE OF WEST VIRGINIA
DEPARTMENT OF MINES
OIL AND GAS DIVISION

1416

WELL RECORD

Oil or Gas Well Gas
(KIND)

Quadrangle Charleston

Permit No. 11827

Company UNITED FUEL GAS CO.

Address P.O. Box 1273, Charleston 25, W. Va.

Farm W. D. Lewis Acres 1598

Location (waters) Campbells Creek

Well No. 6874 Elev. 809.77'

District Malden County Kanawha

The surface of tract is owned in fee by _____

Address _____

Mineral rights are owned by Julia A. Craddock, Agt.

417 Broad St. Address Charleston, W.Va.

Drilling commenced Drilled by Col. Carbon Co.

Drilling completed _____

Date Shot _____ From _____ To _____

With _____

Open Flow _____ /10ths Water in _____ Inch

_____ /10ths Merc. in _____ Inch

Volume 460,000 Cu. Ft.

Rock Pressure _____ lbs. _____ hrs.

Oil _____ bbls., 1st 24 hrs.

Fresh water 845' feet _____ feet


Salt water _____ feet _____ feet

Casing and Tubing	Used in Drilling	Left in Well	Packers
Size			
16			Kind of Packer <u>Larkins</u>
18		<u>10'</u>	Hook Wall
10	<u>62'</u>		Size of _____
8 1/2	<u>364'</u>		
6 3/8		<u>1241'</u>	Depth set <u>1254'</u>
5 3/16			
3			Perf. top _____
2			Perf. bottom _____
Liners Used			Perf. top _____
			Perf. bottom _____

CASING CEMENTED _____ SIZE _____ No. Ft. _____ Date _____

COAL WAS ENCOUNTERED AT 112 FEET 60 INCHES
160 FEET 60 INCHES 312 FEET 36 INCHES
_____ FEET _____ INCHES _____ FEET _____ INCHES

Formation	Color	Hard or Soft	Top	Bottom	Oil, Gas or Water	Depth Found	Remarks
Soil			0	10			
Sand Stone			10	30			
Quick Sand			30	60			
Sand			60	112			
Coal			112	117			
Sand			117	160			
Coal			160	165			
Slate			165	175			
Sand			175	312			
Coal			312	315			
Lime			315	400			
Sand			400	470			
Lime			470	545			
Slate			545	595			
Sand			595	650			
Slate & Shells			650	670			
Sand			670	1070			
Lime			1070	1075			
Sand			1075	1172			
Little Lime			1172	1207			
Slate			1207	1213			
Lime Shells			1213	1219			
Slate			1219	1225			
Black Lime			1225	1235			
Pencil Cave			1235	1238			
Big Lime			1238	1390	Gas 1280', 1303', 1342'.		
Injun Sand			1390	1440			
Red Rock			1440	1450	Gas 1410'		
Black Slate			1450	1472			
Total depth			1472'				

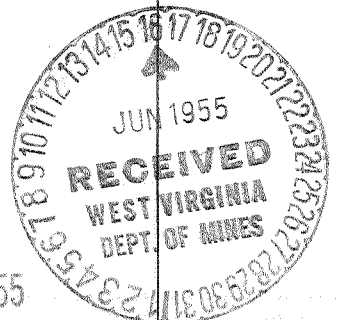

OCT 6 1955

