

New Location...   
 Drill Deeper.....   
 Abandonment.....

JUL 25 1955

Company UNITED FUEL GAS CO.  
 Address CHARLESTON, W. VA.  
 Farm C. B. BOTKIN  
 Tract \_\_\_\_\_ Acres 125 Lease No. 841  
 Well (Farm) No. \_\_\_\_\_ Serial No. 1810  
 Elevation (Spirit Level) 836.0  
 Quadrangle CHARLESTON  
 County KANAWHA District ELK  
 Engineer Paul E. [Signature]  
 Engineer's Registration No. 669  
 File No. 66-65 Drawing No. \_\_\_\_\_  
 Date 6-30-55 Scale 1"=400'

STATE OF WEST VIRGINIA  
 DEPARTMENT OF MINES  
 OIL AND GAS DIVISION  
 CHARLESTON

WELL LOCATION MAP  
 FILE NO. KAN-1185-A

+ Denotes location of well on United States Topographic Maps, scale 1 to 62,500, latitude and longitude lines being represented by border lines as shown.

- Denotes one inch spaces on border line of original tracing.

C. B. BOTKIN No. 1810 - U. F. G. Co. - KAN-1185-A



STATE OF WEST VIRGINIA  
DEPARTMENT OF MINES  
OIL AND GAS DIVISION

1940

WELL RECORD

Quadrangle Charleston

Permit No. 1185-A

Oil or Gas Well Gas  
(KIND)

Company UNITED FUEL GASCOMPANY  
Address P.O. Box 1273, Charleston 25, W. Va.  
Farm C. E. Botkin Acres 125  
Location (waters) Three Mile Fork of Coopers Creek  
Well No. 1810 Eley 836'  
District Elk County Kanawha  
The surface of tract is owned in fee by \_\_\_\_\_  
Address \_\_\_\_\_  
Mineral rights are owned by C. E. Botkin  
Kanawha Valley Bank Address Charleston, W. Va.  
Drilling commenced 5-30-27  
Drilling completed 7-4-27  
Date Shot \_\_\_\_\_ From \_\_\_\_\_ To \_\_\_\_\_  
With \_\_\_\_\_

Casing and Tubing	Used in Drilling	Left in Well	Packers
Size			Kind of Packer
16			<u>Larkin</u>
13			Size of
10	<u>96'</u>		<u>3x6-5/8x16</u>
8 1/4	<u>523'</u>	<u>1531'</u>	Depth set
6 5/8			<u>1621'</u>
5 3/16			Perf. top
3			Perf. bottom
<u>2 1/2</u>		<u>1684</u>	Perf. top
Liners Used			Perf. bottom


Open Flow 104 /10ths Water in 2 Inch  
/10ths Merc. in \_\_\_\_\_ Inch  
Volume 486,000 Cu. Ft.  
Rock Pressure 262 lbs. \_\_\_\_\_ hrs.  
Oil \_\_\_\_\_ bbls., 1st 24 hrs.  
Fresh water 261' feet \_\_\_\_\_ feet  
Salt water 997 feet 1017 feet

CASING CEMENTED \_\_\_\_\_ SIZE \_\_\_\_\_ No. Ft. \_\_\_\_\_ Date \_\_\_\_\_

COAL WAS ENCOUNTERED AT 196 FEET 36 INCHES  
\_\_\_\_ FEET \_\_\_\_\_ INCHES FEET \_\_\_\_\_ INCHES  
\_\_\_\_ FEET \_\_\_\_\_ INCHES FEET \_\_\_\_\_ INCHES

Formation	Color	Hard or Soft	Top	Bottom	Oil, Gas or Water	Depth Found	Remarks
Conductor			0	8			
Red Clay			8	16			
Rock			16	20			
Yellow Clay			20	32			
Slate			32	46			
Sand			46	71			
Slate			71	111			
Lime			111	146			
Slate			146	166			
Sandy Lime			166	196			
Coal			196	199			
Slate			199	211			
Sand			211	246			
Lime			246	261			
Sand			261	283			
Lime			283	313			
Sand			313	328			
Slate			328	373			
Sand			373	408			
Black Lime			408	426			
Sandy Lime			426	471			
Slate			471	535			
Sand			535	570			
Slate			570	604			
Gray Lime			604	626			
Sand			626	676			
Slate			676	700			
Sandy Lime			700	780			
Slate			780	795			
Sand			795	835			
Slate			835	854			
Gas Sand			854	971	Gas at 795'		
Slate			971	977	Gas 967' 9/10 W		
Salt Sand			977	1220			
Slate & Lime			1220	1240			
Salt Sand			1240	1449			
Lime Shells			1449	1481			
Little Lime			1481	1508			
Pencil Cave			1508	1511			

9

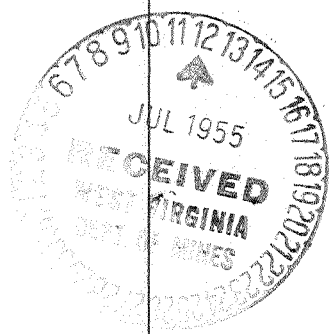

JAN. 23 1958

Formation	Color	Hard or Soft	Top	Bottom	Oil, Gas or Water	Depth Found	Remarks
Big Lime Big Injun			1511 1658	1658 1662½	Gas exhausted at 1588 60,000 cu.ft. at 1614' At 1657' well gauged Gas 1650 4/10 W 310 M Gas 1661 104/10 W		20/10 W 213 M

Date July 8, 1955

APPROVED UNITED FUEL GAS CO., Owner

By *R. J. ...*  
(Title)

Mgr. Civil Engineering Dept.

Plugged

Oil & Gas Division

1955 Annual Report

Table 6

Oil and Gas Wells Abandoned

January-December, 1955

Gene,  
There was no affidavit  
out the plugging date  
was pulled from  
this table.

Susan

1185	United Fuel Gas Co.	C. B. Ecklin	1810	Elk	1927	Gas	1662'	9/4
1186	United Fuel Gas Co.	A. C. Young	1342	Big Sandy	1922	Gas	1512'	7/26
1187	United Fuel Gas Co.	King Land Co.	596	Big Sandy	1911	Gas	2221'	8/11
1188	United Fuel Gas Co.	J. A. Osborne	872	Big Sandy	1917	Gas	1677'	8/20
1189	United Fuel Gas Co.	K. J. Shacklin	1659	Big Sandy	1926	Gas	1687'	8/12
1190	United Fuel Gas Co.	Grant Coppenhaver	286	Elk	1911	Gas	1723'	8/16
1191	Leroy Cassidy	W. H. & T. J. Clime	3266	Elk	1916	Gas-011	1764'	11/1
1192	Leroy Cassidy	Ethel Price	2864	Elk	1912	Gas-011	1654'	9/17
1193	United Fuel Gas Co.	L. V. Koertz-J. A. Osborne-1339	Str-1111	Big Sandy	1923	Gas	1775'	9/16
1194	The Pure Oil Co.	Williams Coal Co.	101	Cabin Crk.	1917	Oil	2507'	
1195	The Pure Oil Co.	Williams Coal Co.	101	Cabin Crk.	1917	Oil	2912'	
1196	The Pure Oil Co.	Williams Coal Co.	110	Cabin Crk.	1918	Water Inj.	3079'	
1197	The Pure Oil Co.	Williams Coal Co.	110	Cabin Crk.	1918	Water Inj.	2948'	
1198	The Pure Oil Co.	Williams Coal Co.	115	Cabin Crk.	1918	Oil	2697'	
1199	The Pure Oil Co.	Williams Coal Co.	120	Cabin Crk.	1918	Oil	2610'	
1200	The Pure Oil Co.	Williams Coal Co.	123	Cabin Crk.	1918	Oil	2780'	
1201	The Pure Oil Co.	Williams Coal Co.	147	Cabin Crk.	1918	Water Inj.	3168'	
1202	The Pure Oil Co.	Williams Coal Co.	154	Cabin Crk.	1918	Water Inj.	2889'	
1203	The Pure Oil Co.	Williams Coal Co.	155	Cabin Crk.	1918	Water Inj.	3182'	
1204	The Pure Oil Co.	Williams Coal Co.	183	Cabin Crk.	1919	Water Inj.	3114'	
1205	The Pure Oil Co.	Williams Coal Co.	187	Cabin Crk.	1920	Water Inj.	3039'	
1206	The Pure Oil Co.	Williams Coal Co.	188	Cabin Crk.	1920	Oil	3074'	
1207	The Pure Oil Co.	Williams Coal Co.	191	Cabin Crk.	1921	Oil	3203'	
1208	The Pure Oil Co.	Williams Coal Co.	192	Cabin Crk.	1921	Water Inj.	3046'	
1209	The Pure Oil Co.	Williams Coal Co.	163	Cabin Crk.	1921	Oil	3112'	
1210	The Pure Oil Co.	Williams Coal Co.	195	Cabin Crk.	1928	Water Inj.	3221'	
1211	The Pure Oil Co.	Williams Coal Co.	196	Cabin Crk.	1921	Oil	3167'	
1212	The Pure Oil Co.	Williams Coal Co.	200	Cabin Crk.	1921	Oil	3276'	
1213	The Pure Oil Co.	Williams Coal Co.	243	Cabin Crk.	1920	Oil	3413'	
1214	The Pure Oil Co.	Williams Coal Co.	199	Cabin Crk.	1929	Water Inj.	3355'	
1215	The Pure Oil Co.	Williams Coal Co.	235	Cabin Crk.	1928	Water Inj.	3238'	
1216	The Pure Oil Co.	Williams Coal Co.	236	Cabin Crk.	1928	Water Inj.	3320'	
1217	The Pure Oil Co.	Williams Coal Co.	238	Cabin Crk.	1928	Oil	3202'	
1218	The Pure Oil Co.	Williams Coal Co.	242	Cabin Crk.	1929	Water Inj.	3335'	
1219	Leroy Cassidy	J. H. Coppenhaver	2910	Elk	1912	Gas-011	2060'	12/2
1220	United Fuel Gas Co.	V. F. Johnson	775	Cabin Crk.	1913	Gas	1839'	
1221	Pipe Sales & Supply, Inc.	William Young Hrs.	2923	Big Sandy	1912	Gas-011	1668'	
1222	Pipe Sales & Supply, Inc.	M. & Nancy J. Van Camp	3158	Elk	1915	Gas	2134'	11/25
1223	United Fuel Gas Co.	Queen Land Co.	3879	Elk	1916	Gas-011	2118'	
1224	United Fuel Gas Co.	Williams Coal Co.	245	Big Sandy	1929	Gas	1919'	11/19
2-P	The Pure Oil Co.	Williams Coal Co.	193	Cabin Crk.	1929	Oil	3313'	
3-P	The Pure Oil Co.	Williams Coal Co.	247	Cabin Crk.	1929	Oil	3278'	
20-P	United Fuel Gas Co.	Williams Coal Co.	4036	Cabin Crk.	1930	Oil	3346'	
32-P	United Fuel Gas Co.	Black Hand Coal & Coke	3980	Loulan	1929	Gas	1448'	9/10
34-P	United Fuel Gas Co.	Sunday Crk. Coal Co.	4098	Cabin Crk.	1929	Gas	2287'	1/28
54-P	The Pure Oil Co.	George Crk. Id. & Hng.	253	Malden	1930	Gas	1857'	5/4
67-P	The Pure Oil Co.	Williams Coal Co.	4278	Cabin Crk.	1930	Oil	3327'	
89-P	United Fuel Gas Co.	U. F. Gas Co. Fee	6875	Malden	1931	Gas	2356'	5/1
172-P	United Fuel Gas Co.	W. D. Lewis	8975	Malden	1935	Gas	4611'	8/16
204-P	Cortroy L. Cabot, Inc.	Campbell's Crk. Coal Co.	859	Malden	1936	Gas	4796'	Cancelled
211-P	The Pure Oil Co.	Williams Coal Co.	263	Cabin Crk.	1936	Oil	3212'	
215-P	The Pure Oil Co.	Williams Coal Co.	264	Cabin Crk.	1936	Oil	3569'	
219-P	The Pure Oil Co.	Williams Coal Co.	265	Cabin Crk.	1936	Oil	3394'	
289-P	The Pure Oil Co.	Williams Coal Co.	266	Cabin Crk.	1936	Oil	3242'	
295-P	The Pure Oil Co.	Williams Coal Co.	267	Cabin Crk.	1936	Oil	3314'	
347-P	The Pure Oil Co.	Williams Coal Co.	272	Cabin Crk.	1937	Oil	3152'	
355-P	The Pure Oil Co.	Williams Coal Co.	273	Cabin Crk.	1937	Oil	3111'	
358-P	United Fuel Gas Co.	Williams Coal Co.	4774	Malden	1937	Gas	4772'	8/18
366-P	Geoffrey L. Cabot, Inc.	J. C. Fisher et al	Str-903	Malden	1937	Gas	4881'	
369-P	The Pure Oil Co.	Williams Coal Co.	274	Cabin Crk.	1938	Oil	3324'	
391-P	United Fuel Gas Co.	D. M. Canterbury	4753	Elk	1937	Gas	5156'	5/21
499-P	The Pure Oil Co.	Williams Coal Co.	282	Cabin Crk.	1938	Oil	3360'	
520-P	The Pure Oil Co.	Williams Coal Co.	287	Cabin Crk.	1938	Oil	3269'	
555-P	Columbian Carbon Co.	Bratten Hanna	GM-4118	Elk	1938	Gas	5057'	
654-P	United Fuel Gas Co.	Hattie J. Trants	4858	Halden	1939	Gas	5170'	10/11
823-P	South Penn Nat'l Gas Co.	Clendenth Robinson	1	Poca	1939	Gas	2170'	2/25
1022-P	Olenn Dearth	Robert Wines	2	Poca	1941	Gas	5127'	6/10
1107-P	United Fuel Gas Co.	Gallatin Hng. Co. #2	5370	Cabin Crk.	1943	Gas	1662'	6/13
1127-P	United Fuel Gas Co.	Payne Gallatin Hng. Co.	5473	Cabin Crk.	1943	Gas	1662'	10/17
1131-P	United Fuel Gas Co.	Courtesy Coal Co.	5490	Cabin Crk.	1944	Gas	2038'	4/1
1137-P	The Pure Oil Co.	Williams Coal Co.	310	Cabin Crk.	1948	Oil	3219'	5/28
1138-P	The Pure Oil Co.	Williams Coal Co.	6263	Elk	1948	Gas	5209'	4/28
1153-P	United Fuel Gas Co.	James S. Burger et al	324	Cabin Crk.	1949	Water Inj.	3113'	
1154-P	The Pure Oil Co.	Williams Coal Co.	325	Cabin Crk.	1948	Water Inj.	3001'	
1162-P	The Pure Oil Co.	Williams Coal Co.	327	Cabin Crk.	1949	Water Inj.	3274'	12/16
1530-P	Cameron Producing Company	Kathryn Cadolph Hrs.	2	Union	1950	Gas	4762'	