


Latitude 38° 30'

Longitude 81° 25'

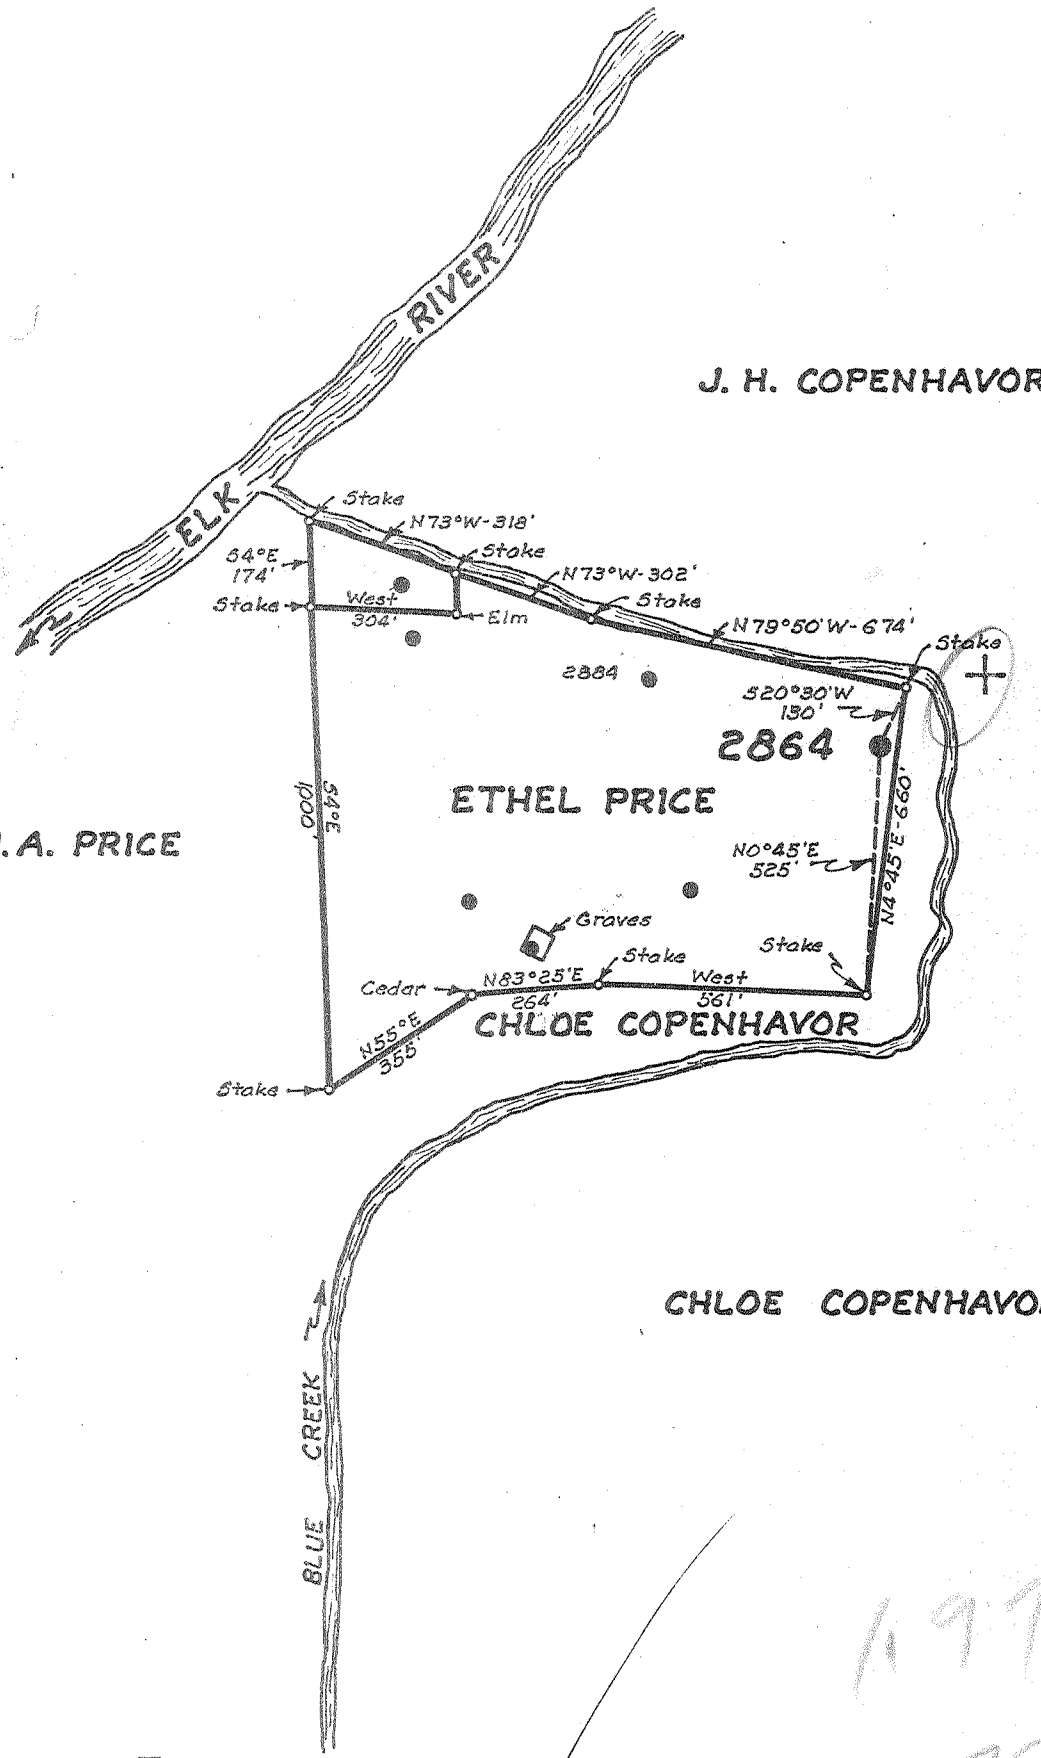

New Location
 Drill Deeper
 Abandonment

✓ SEP 19 1955

197 W
 3.77 2

Company	LEROY CASSADY
Address	ELKVIEW, W. VA.
Farm	ETHEL PRICE
Tract	Acres 26 Lease No. 776
Well (Farm) No.	3 Serial No. 2864
Elevation (Spirit Level)	609.0'
Quadrangle	GLENDENIN
County	KANAWHA District ELK
Engineer	<i>Paul E. Jackson</i>
Engineer's Registration No.	663
File No.	70-65 Drawing No.
Date	8-28-55 Scale 1"=400'

STATE OF WEST VIRGINIA
 DEPARTMENT OF MINES
 OIL AND GAS DIVISION
 CHARLESTON

WELL LOCATION MAP
 FILE NO. KAN-1192-A

+ Denotes location of well on United States Topographic Maps, scale 1 to 62,500, latitude and longitude lines being represented by border lines as shown.
 - Denotes one inch spaces on border line of original tracing.

ETHEL PRICE No. 3 (2864) - LEROY CASSADY - KAN-1192-A



STATE OF WEST VIRGINIA
DEPARTMENT OF MINES
OIL AND GAS DIVISION

2002

Quadrangle Glendon

Permit No. Kan-1192-A

WELL RECORD

Oil or Gas Well _____
(KIND)

Company Leroy Cassady
 Address RFD #1 - Elkview, W. Va.
 Farm Ethel Price Acres 26
 Location (waters) _____
 Well No. 3 2864 Elev. 609
 District Elk County Kanawha
 The surface of tract is owned in fee by _____
 Address _____
 Mineral rights are owned by _____
 Address _____
 Drilling commenced April 9, 1912
 Drilling completed April 29, 1912
 Date Shot _____ From _____ To _____
 With _____
 Open Flow _____ /10ths Water in _____ Inch
 _____ /10ths Merc. in _____ Inch
 Volume _____ Cu. Ft.
 Rock Pressure _____ lbs. _____ hrs.
 Oil _____ bbls., 1st 24 hrs.
 Fresh water _____ feet _____ feet
 Salt water _____ feet _____ feet

Casing and Tubing	Used in Drilling	Left in Well	Packers
Size			
16			Kind of Packer
13			
10	50'	50'	Size of
8 1/4	390'		
6 5/8	1404'	1404'	Depth set
5 3/16			
3			Perf. top
2			Perf. bottom
Liners Used			Perf. top
			Perf. bottom

CASING CEMENTED _____ SIZE _____ No. Ft. _____ Date _____

COAL WAS ENCOUNTERED AT _____ FEET _____ INCHES
 _____ FEET _____ INCHES FEET _____ INCHES
 _____ FEET _____ INCHES FEET _____ INCHES

Formation	Color	Hard or Soft	Top	Bottom	Oil, Gas or Water	Depth Found	Remarks
Clay			0	16			
Sand			16	56			
Slate & Shell			56	256			
Sand			256	300			
Slate			300	320			
Sand			320	380			
Slate			380	420			
Sand			420	450			
Slate & Shell			450	760			
SALT SAND			760	1225			
Red Rock			1225	1245			
Slate			1245	1270			
Lime & Slate			1270	1280			
Red Rock			1280	1290			
Lime & Slate			1290	1336			
Little Lime			1336	1366			
Pencil Cave			1366	1373			
Slate & Shell			1373	1400			
Big Lime			1400	1550			
Slate & Shell			1550	1643			
Oil Sand			1643	1660			
Total Depth				1664			

Hole filled up with water 850'

