


Latitude 38° 10'

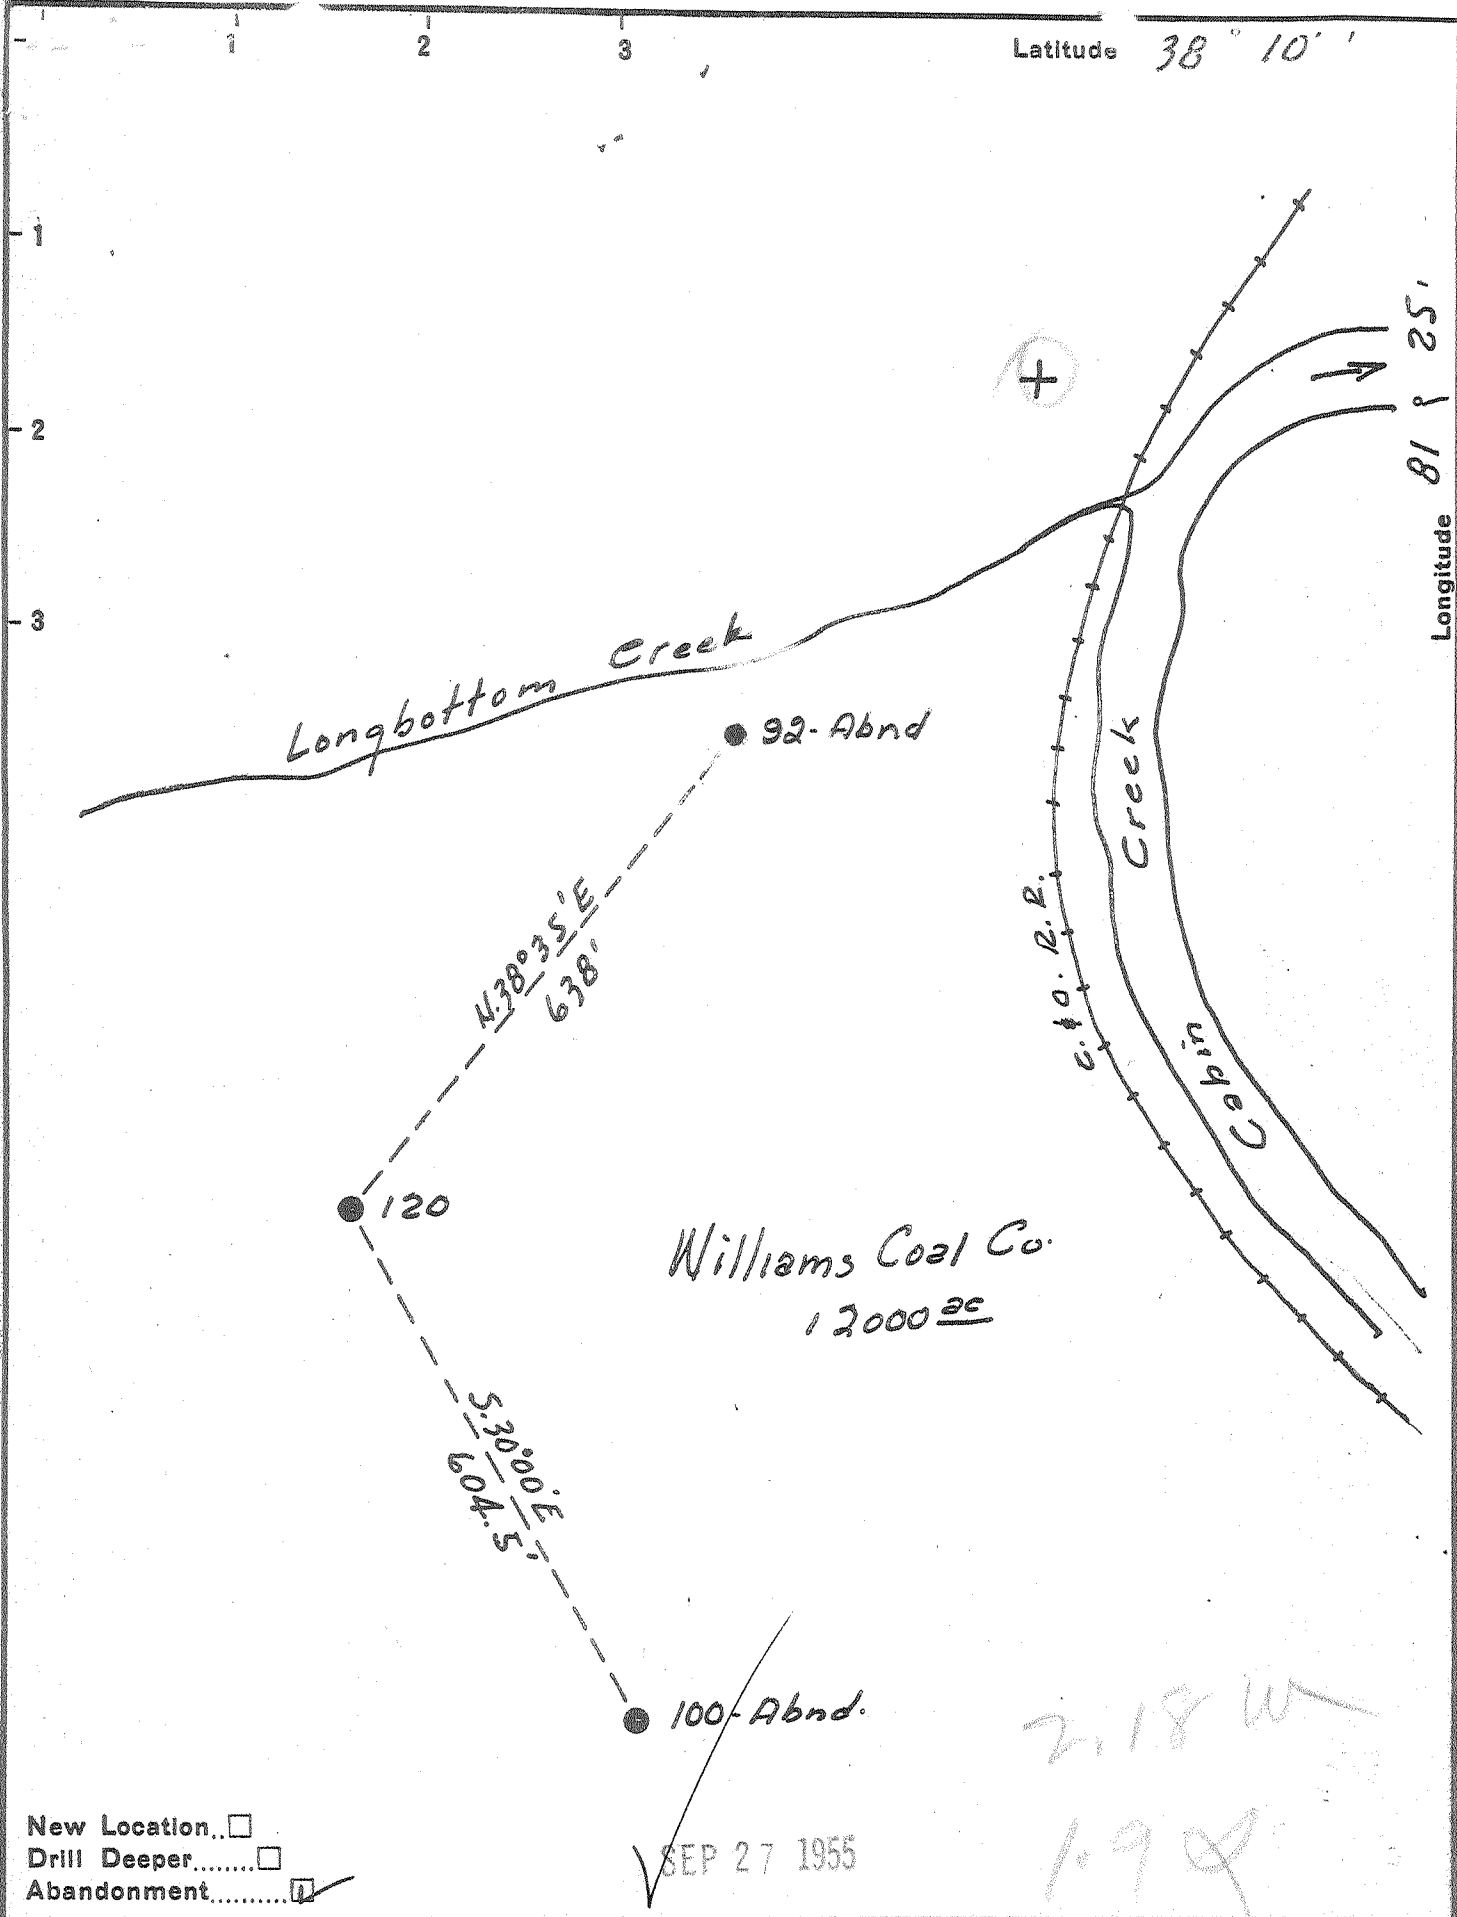

New Location...   
 Drill Deeper.....   
 Abandonment.....

SEP 27 1955

Company The Pure Oil Co.  
 Address Newark, Ohio  
 Farm Williams Coal Co.  
 Tract \_\_\_\_\_ Acres 12000 Lease No. 5012  
 Well (Farm) No. 120 Serial No. 415  
 Elevation (Spirit Level) 931  
 Quadrangle Montgomery W.V.  
 County Kenosha District Cabin Creek  
 Engineer J. J. Hunter  
 Engineer's Registration No. Ohio-2912  
 File No. \_\_\_\_\_ Drawing No. \_\_\_\_\_  
 Date 2-23-53 Scale 1" = 200'

STATE OF WEST VIRGINIA  
 DEPARTMENT OF MINES  
 OIL AND GAS DIVISION  
 CHARLESTON

WELL LOCATION MAP  
 FILE NO. KAN-1199-A

+ Denotes location of well on United States Topographic Maps, scale 1 to 62,500, latitude and longitude lines being represented by border lines as shown.

- Denotes one inch spaces on border line of original tracing.

6-6240



STATE OF WEST VIRGINIA  
DEPARTMENT OF MINES  
OIL AND GAS DIVISION

2020

Montgomery Road  
Ab 1199-A

WELL RECORD

Oil or Gas Well Oil

Permit No. \_\_\_\_\_ (KIND)

Company The Pure Oil Company  
Address P.O. Box 551 - Newark, Ohio  
Farm Williams Coal Company Acres 12,000  
Location (waters) Cabin Creek  
Well No. 120 Elev. 931.5  
District Cabin Creek County Kanawha  
The surface of tract is owned in fee by Shonk Land Co.  
802 Kan Bnkg & Trust Co, Bldg, Charleston, W.Va.  
Address  
Mineral rights are owned by Ditto  
Address  
Drilling commenced September 28, 1917  
Drilling completed January 21, 1918  
Date Shot 5-10-18 From 2587 To 2605  
With 80 Qts. glycerin  
Open Flow /10ths Water in \_\_\_\_\_ Inch  
/10ths Merc. in \_\_\_\_\_ Inch  
Volume \_\_\_\_\_ Cu. Ft.  
Rock Pressure \_\_\_\_\_ lbs. \_\_\_\_\_ hrs.  
Oil 40 bbls., 1st 24 hrs.  
Fresh water \_\_\_\_\_ feet  
Salt water \_\_\_\_\_ feet

Casing and Tubing	Used in Drilling	Left in Well	Packers
Size			
16			Kind of Packer
13			
10	350'	350'	Size of
8 1/4	1280	1280	
6 5/8	1937	1937	Depth set
5 3/16			
3 1/2	2588	2588	Perf. top
<del>2 1/2</del>			Perf. bottom
Liners Used			Perf. top
			Perf. bottom

CASING CEMENTED \_\_\_\_\_ SIZE \_\_\_\_\_ No. Ft. \_\_\_\_\_ Date \_\_\_\_\_

COAL WAS ENCOUNTERED AT 310 FEET 36 INCHES  
345 FEET 60 INCHES FEET INCHES  
FEET INCHES FEET INCHES

Formation	Color	Hard or Soft	Top	Bottom	Oil, Gas or Water	Depth Found	Remarks
Clay			0	10			
Sand			10	50			
Slate			50	70			
Sand			70	150			
Slate			150	200			
Lime			200	250			
Slate			250	300			
Sand			300	310			
Coal			310	313			
Lime			313	345			
Coal			345	350			
Slate			350	380			
Sand			380	475			
Slate			475	520			
Lime			520	540			
Slate			540	615			
Shells			615	680			
Slate			680	705			
Lime			705	790			
GRAMPUS lime			790	910			
Slate			910	965			
SALT SAND			965	1280			
Slate			1280	1410			
Red Rock			1410	1440			
Shells			1440	1690			
MAXON SAND			1690	1810			
Little Lime			1810	1913			
BIG LIME			1913	2115			
INJUN SAND			2115	2145			
Slate shells			2145	2540			
Brown shale			2540	2560			
BEREA SAND			2560	2605			
Lime			2605	2610	oil		
TOTAL DEPTH				2610		Berea Sand	

