

New Location
 Drill Deeper
 Abandonment

Company The Pure Oil Co.
 Address Newark, Ohio
 Farm Williams Coal Co.
 Tract _____ Acres 12000 Lease No. 5012
 Well (Farm) No. 123 Serial No. 416
 Elevation (Spirit Level) 1097
 Quadrangle Montgomery
 County Monroe District Cabin Creek
 Engineer J. B. Hunter
 Engineer's Registration No. Ohio-2912
 File No. _____ Drawing No. _____
 Date 2-23-53 Scale 1" = 200'

STATE OF WEST VIRGINIA
 DEPARTMENT OF MINES
 OIL AND GAS DIVISION
 CHARLESTON

WELL LOCATION MAP
 FILE NO. KAN-1200-A

+ Denotes location of well on United States Topographic Maps, scale 1 to 62,500, latitude and longitude lines being represented by border lines as shown.
 - Denotes one inch spaces on border line of original tracing.



STATE OF WEST VIRGINIA
DEPARTMENT OF MINES
OIL AND GAS DIVISION

1102

Montgomery
Permit No. 1200-A

WELL RECORD


Oil or Gas Well oil
(KIND)

Company The Pure Oil Company
 Address P.O. Box 551 - Newark, Ohio
 Farm Williams Coal Company Acres 12,000
 Location (waters) Cabin Creek
 Well No. 123 Elev. 1097
 District Cabin Creek County Kanawha
 The surface of tract is owned in fee by Shonk Land Co.
802 Kan.Bnkg & Trust Co. Bldg., Charleston, W. Va.
 Mineral rights are owned by Ditto
 Address _____
 Drilling commenced April 27, 1918
 Drilling completed August 2, 1918
 Date Shot 10-15-18 From 2745 To 2765
7-29-24 From 2745 To 2765
 With 80 and 120 Qts.
 Open Flow /10ths Water in _____ Inch
 /10ths Merc. in _____ Inch
 Volume _____ Cu. Ft.
 Rock Pressure _____ lbs. _____ hrs.
 Oil 40 bbls., 1st 24 hrs.
 Fresh water _____ feet _____ feet
 Salt water _____ feet _____ feet

Casing and Tubing	Used in Drilling	Left in Well	Packers
Size			
16			Kind of Packer
18			
10	430	430'	Size of
8 1/2	1425	0	
6 5/8	2078	2078	Depth set
5 3/16			
3			Perf. top
2	2766	2766	Perf. bottom
Liners Used			Perf. top
			Perf. bottom

CASING CEMENTED _____ SIZE _____ No. Ft. _____ Date _____
 COAL WAS ENCOUNTERED AT 250 FEET 60 INCHES
425 FEET 60 INCHES FEET INCHES
 FEET INCHES FEET INCHES

Formation	Color	Hard or Soft	Top	Bottom	Oil, Gas or Water	Depth Found	Remarks
Soil			0	16			
Lime			16	100			
Slate			100	150			
Sand			150	200			
Slate			200	250			
Coal			250	255			
Slate			255	275			
Lime			275	350			
Slate			350	400			
Sand			400	425			
Coal			425	430			
Line shells			430	555			
Sand			555	630			
Line			630	730			
Sand			730	800			
Slate			800	875			
Lime			875	895			
GRAMPUS lime			895	1075			
Slate			1075	1130			
SALT SAND			1130	1420			
Lime			1420	1470			
Shells			1470	1570			
Lime			1570	1590			
Red Rock			1590	1635			
Sand			1635	1685			
Shells			1685	1895			
MAXON SAND			1895	1980			
Little Lime			1980	2065			
Pencil Cave			2065	2070			
BIG LIME			2070	2290			
INJUN SAND			2290	2320			
Slate & shells			2320	2710			
Brown shale			2710	2719			
BEREA SAND			2719	2765	oil	Berea	
Slate			2765	2770			
TOTAL DEPTH				2770			
Present Total Depth				2780			

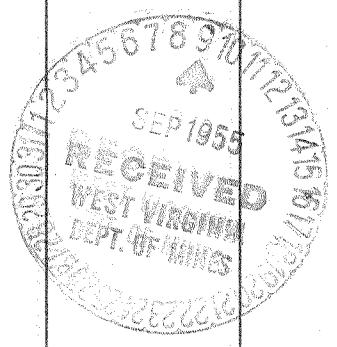

JUN 20 1957

