

New Location..
 Drill Deeper.....
 Abandonment.....

NOV 22 1955

Handwritten notes:
 143 W
 5148 D

Company PIPE SALES & SUPPLY, INC.
 Address CHARLESTON, W. VA.
 Farm M. & NANCY J. VAN CAMP
 Tract _____ Acres 116 1/4 Lease No. _____
 Well (Farm) No. 3 Serial No. 3283
 Elevation (Spirit Level) 1026.7
 Quadrangle CLENDENIN
 County KANAWHA District ELK
 Engineer PAUL E. JOACHIM
 Engineer's Registration No. 669
 File No. 72-63 Drawing No. _____
 Date OCT. 21, 1955 Scale 1" = 400'

STATE OF WEST VIRGINIA
 DEPARTMENT OF MINES
 OIL AND GAS DIVISION
 CHARLESTON

WELL LOCATION MAP
 FILE NO. KAN-1223-A

+ Denotes location of well on United States Topographic Maps, scale 1 to 62,500, latitude and longitude lines being represented by border lines as shown.

- Denotes one inch spaces on border line of original tracing.

Handwritten: 6-0 217



STATE OF WEST VIRGINIA
DEPARTMENT OF MINES
OIL AND GAS DIVISION

2006

Quadrangle Cunderin

WELL RECORD

Permit No. Kan-1223-A


Oil or Gas Well X (KIND)

Company The Ohio Fuel Oil Company
Address Charleston, West Virginia
Farm M. & Nancy J. Van Camp Acres 116
Location (waters) _____
Well No. 3, Serial 3283 Elev. 1026.7'
District Elk County Kanawha
The surface of tract is owned in fee by _____
Address _____
Mineral rights are owned by _____
Address _____
Drilling commenced August 5, 1916
Drilling completed September 25, 1916
Date Shot 9/26/16 From _____ To _____
With 140 qts.
Open Flow /10ths Water in _____ Inch
/10ths Merc. in _____ Inch
Volume _____ Cu. Ft.
Rock Pressure _____ lbs. _____ hrs.
Oil _____ bbls., 1st 24 hrs.
Fresh water _____ feet _____ feet
Salt water _____ feet _____ feet

Casing and Tubing	Used in Drilling	Left in Well	Packers
Size			
16			Kind of Packer
13			
10			Size of
8 1/4	613'	Pulled	
6 3/8	1722'	1722'	Depth set
5 3/16			
3			Perf. top
2			Perf. bottom
Liners Used			Perf. top
			Perf. bottom

CASING CEMENTED	SIZE	No. Ft.	Date
COAL WAS ENCOUNTERED AT		FEET	INCHES
	FEET	INCHES	FEET
	FEET	INCHES	FEET

Formation	Color	Hard or Soft	Top	Bottom	Oil, Gas or Water	Depth Found	Remarks
Red Rock				15			
Sand			15	25			
Slate			25	45			
Shells and Sand			45	75			
Sand			75	345			
Sand			345	365			
COAL			365	368			
Sand			368	420			
Slate			420	430			
Lime			430	455			
COAL			455	460			
Slate			460	472			
Sand			472	590			
Slate			590	600			
Sand			600	620			
Sandy Lime			620	670			
Shale			670	820			
Sand			820	835			
Lime			835	875			
Shale			875	895			
Sand			895	925			
Shale			925	955			
Lime & Sand			955	975			
Lime			975	1040			
Sand			1040	1110			
SALT SAND			1110	1492			
Slate			1492	1518			
Lime Shells			1518	1535			
Slate & Red Rock			1535	1614			
MAXON SAND			1614	1628			
Slate			1628	1657			
LITTLE LIME			1657	1680			
Slate			1680	1690			
Lime			1690	1700			
Pencil Cave			1700	1712			
BIG LIME			1712	1872			
Slate			1872	1882			

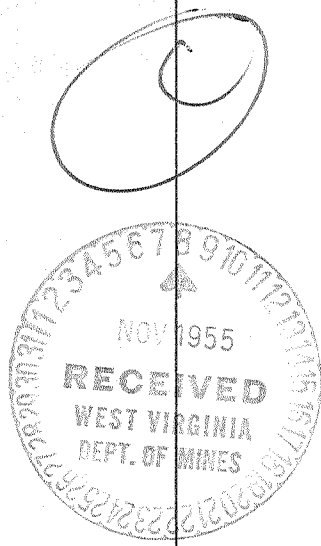

Hole full water 1080'

(OVER)

MAR 20 1957

(Over)

Formation	Color	Hard or Soft	Top	Bottom	Oil, Gas or Water	Depth Found	Remarks
Red Rock			1882	1900			
Lime			1900	1935			
Slate			1935	2010	First Gas	2010'	
WEIR SAND			2010	2114	Black Oil	2016'	
Total Depth				2118	Green Oil	2050'	
					Flowing	2113'	
					Bottom Sand	2114'	

Date _____, 19__

APPROVED _____, Owner

By _____ (Title)