

New Location...

Drill Deeper.....

Abandonment..... MONROE CO., % CHAS. NAT. BANK, CHARLESTON, W. VA. COAL OWNER

Company	RICHARD JACKSON
Address	CHARLESTON, W. VA.
Farm	W. A. McCORKLE
Tract	9 Acres 337 1/2 Lease No.
Well (Farm) No.	14 Serial No. F2308
Elevation (Spirit Level)	1103
Quadrangle	CLENDENIN
County	KANAWHA District ELK
Engineer	PAUL E. JOACHIM
Engineer's Registration No.	669
File No.	74-63 Drawing No.
Date	JAN. 18, 1956 Scale 1" = 400'

STATE OF WEST VIRGINIA
 DEPARTMENT OF MINES
 OIL AND GAS DIVISION
 CHARLESTON

WELL LOCATION MAP
 FILE NO. KAN-1228-A

+ Denotes location of well on United States Topographic Maps, scale 1 to 62,500, latitude and longitude lines being represented by border lines as shown.

- Denotes one inch spaces on border line of original tracing.

6-02-18

W. A. McCORKLE No. 1A (F-2308) - RICHARD JACKSON - KAN-1228-A



STATE OF WEST VIRGINIA
DEPARTMENT OF MINES
OIL AND GAS DIVISION

1917

Formerly: South Penn Oil Company

WELL RECORD

Permit No. 128-1

Oil or Gas Well Oil
(KIND)


Company Wilhelm and Jackson
 Address Hanlin, West Virginia
 Farm W. A. McCorkle Acres 337 1/2
 Location (waters) _____
 Well No. 14 Elev. 1103
 District Blk County Marshall
 The surface of tract is owned in fee by _____
 Address _____
 Mineral rights are owned by _____
 Address _____
 Drilling commenced July 20, 1916
 Drilling completed September 8, 1916
 Date Shot From _____ To _____
 With _____
 Open Flow /10ths Water in _____ Inch
 /10ths Merc. in _____ Inch
 Volume _____ Cu. Ft.
 Rock Pressure _____ lbs. _____ hrs.
 Oil _____ bbls., 1st 24 hrs.
 Fresh water _____ feet _____ feet
 Salt water _____ feet _____ feet

Casing and Tubing	Used in Drilling	Left in Well	Packers
Size			Kind of Packer
16			
13			
10			Size of
8 1/2			
6 1/2		<u>1739'</u>	with Steel Shoe Depth set
5 3/16	<u>not visible</u>		
3			Perf. top
2			Perf. bottom
Liners Used			Perf. top
			Perf. bottom

CASING CEMENTED _____ SIZE _____ No. Ft. _____ Date _____

COAL WAS ENCOUNTERED AT _____ FEET _____ INCHES
 _____ FEET _____ INCHES _____ FEET _____ INCHES
 _____ FEET _____ INCHES _____ FEET _____ INCHES

Formation	Color	Hard or Soft	Top	Bottom	Oil, Gas or Water	Depth Found	Remarks
Conductor			0	16			
COAL			None showing				
SALT SAND			985	1470			hole full of water, 1160'
MAXON			1605	1638			
Little Lime			1689	1691			
BIG LIME			1720	1873	Gas 1796'		
Pencil Cave			1799	1722			
Weir Sand			1912	2117	Gas 2012'		
OIL			2105				
OIL			2117				
Total Depth				2120			
SHOT RECORD							
				DATE	SIZE SHOT	TOP SHELL	
				9/11/16	10	2106'	
				11/3/18	10	2106'	
				6/18/19	30	2106'	
				6/18/19	30	2107'	
				9/18/20	40	2104'	
				3/27/27	40	2108'	

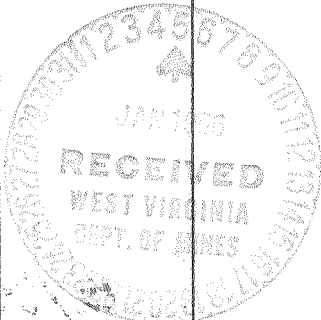

OCT 26 1956