

Company RICHARD JACKSON

Address CHARLESTON, W. VA.

Farm BLUE CREEK TRACT

Tract _____ Acres 29,768 Lease No. 57822

Well (Farm) No. 16 & 34 Serial No. F-1492
F-1430

Elevation (Spirit Level) *16-1326'; *34-1055'

Quadrangle CLENDENIN

County KANAWHA District #16-ELK
#34-BIG SANDY

Engineer PAUL E. JOACHIM

Engineer's Registration No. 669

File No. 76-63 Drawing No. _____

Date JAN. 7, 1956 Scale 1" = 400'

STATE OF WEST VIRGINIA
DEPARTMENT OF MINES
OIL AND GAS DIVISION
CHARLESTON

WELL LOCATION MAP

FILE NO. KAN-1229-A-#16
KAN-1231-A-#34

+ Denotes location of well on United States Topographic Maps, scale 1 to 62,500, latitude and longitude lines being represented by border lines as shown.

- Denotes one inch spaces, on border line of original tracing.

6-0-217

BLUE CREEK TRACT NOS. 16 & 34 - RICHARD JACKSON - KAN-1229-A
KAN-1231-A



STATE OF WEST VIRGINIA
DEPARTMENT OF MINES
OIL AND GAS DIVISION

1973

WELL RECORD

Permit No. _____ Oil or Gas Well oil
(KIND)

Company Wilhelm and Jackson (Auth. Perm. 6. hcd)
Address Hanlin, West Virginia
Farm Blue Creek Tract Acres 29,768
Location (waters) _____
Well No. 16 Elev. 1326'
District Elk County Kanawha
The surface of tract is owned in fee by _____
Address _____
Mineral rights are owned by _____
Address _____
Drilling commenced March 29, 1913
Drilling completed May 31, 1913
Date Shot From 2346 To 2350
With _____
Open Flow /10ths Water in _____ Inch
/10ths Merc. in _____ Inch
Volume _____ Cu. Ft.
Rock Pressure _____ lbs. _____ hrs.
Oil _____ bbls., 1st 24 hrs.
Fresh water _____ feet _____ feet
Salt water _____ feet _____ feet

Casing and Tubing	Used in Drilling	Left in Well	Packers
Size			Kind of Packer
16			B & H
13			Size of
10			Depth set
8 1/2	1995	1995	Perf. top
6 1/2			Perf. bottom
5 3/16			Perf. top
3			Perf. bottom
2			
Liners Used			


CASING CEMENTED _____ SIZE _____ No. Ft. _____ Date _____

COAL WAS ENCOUNTERED AT _____ FEET _____ INCHES
_____ FEET _____ INCHES _____ FEET _____ INCHES
_____ FEET _____ INCHES _____ FEET _____ INCHES

Formation	Color	Hard or Soft	Top	Bottom	Oil, Gas or Water	Depth Found	Remarks
Conductor				14			
Sand			14	60			
Slate			60	85			
Lime			85	120			
Sand			120	536			
COAL			536	542			
Lime			542	590			
Sand			590	630			
Lime			630	660			
Sand			660	740			
Lime			740	800			
Sand			800	840			
Slate & Shale			840	970			
Sand			970	1040			
Slate & Shale			1040	1125			
Sand			1125	1150			
Slate			1150	1175			
Sand			1175	1270			
Slate			1270	1280			
SALT SAND			1280	1790			
Red Rock			1790	1820			
Slate			1820	1825			
Lime			1825	1890			
Red Rock			1890	1895			
MAXON SAND			1895	1923			
Slate			1923	1925			
Little Lime			1925	1958			
Pencil Cave			1958	1975			
BIG LIMES			1975	2146			
Red Rock			2146	2250			
Sand			2250	2310			
Weir Sand			2310	2365			
Slate			2365	2367			
Total Depth				2367			

SHOT RECORD

DATE	SIZE SHOT	TOP OF SHELL
1/20/14	10	2348
9/2/15	20	2348
9/7/17	30	2346
4/28/26	20	2348
7/11/40	40	2350

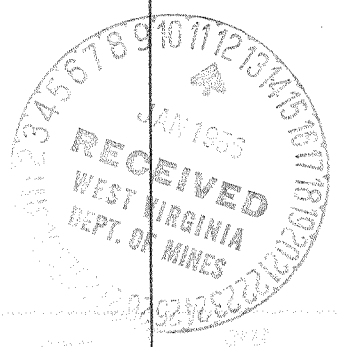

(Over)

OCT. 26 1956