

New Location...
 Drill Deeper.....
 Abandonment.....

JAN. 31 1956

Company RICHARD JACKSON
 Address CHARLESTON, W. VA.
 Farm BLUE CREEK TRACT
 Tract _____ Acres 29,768 Lease No. 57822
 Well (Farm) No. 16 & 34 Serial No. F-1492
 Elevation (Spirit Level) *16-1326'; *34-1055'
 Quadrangle CLENDENIN
 County KANAWHA District *16-ELK
 Engineer PAUL E. JOACHIM
 Engineer's Registration No. 669
 File No. 76-63 Drawing No. _____
 Date JAN. 7, 1956 Scale 1" = 400'

STATE OF WEST VIRGINIA
 DEPARTMENT OF MINES
 OIL AND GAS DIVISION
 CHARLESTON

WELL LOCATION MAP

FILE NO. KAN-1229-A-#16
KAN-1231-A-#34

+ Denotes location of well on United States Topographic Maps, scale 1 to 62,500, latitude and longitude lines being represented by border lines as shown.

- Denotes one inch spaces on border line of original tracing.

6-0-218

BLUE CREEK TRACT NOS. 16 & 34 - RICHARD JACKSON - KAN-1229 A
 KAN-1231 A



STATE OF WEST VIRGINIA
DEPARTMENT OF MINES
OIL AND GAS DIVISION

1913

Formerly, South Penn Oil Company

WELL RECORD

Permit No. 1731-4

Company Wilhelm and Jackson

Address Hamlin, W. Va.

Farm Blue Creek Tract Acres 29,768

Location (waters) 34

Well No. 34 Elev. 1055'

District Elk County Kanawha

The surface of tract is owned in fee by _____
Address _____

Mineral rights are owned by _____
Address _____

Drilling commenced November 21, 1913

Drilling completed January 14, 1914

Date Shot From 2060' To 2062'

With _____

Open Flow /10ths Water in _____ Inch
/10ths Merc. in _____ Inch

Volume _____ Cu. Ft.

Rock Pressure _____ lbs. _____ hrs.

Oil _____ bbls., 1st 24 hrs.

Fresh water _____ feet _____ feet


Salt water _____ feet _____ feet

Oil or Gas Well Oil
(KIND)

Casing and Tubing	Used in Drilling	Left in Well	Packers
Size			Kind of Packer
16			
13			
10			Size of
8 1/4		563'	
6 3/4		1736'	Depth set
5 3/16			
3			Perf. top
2			Perf. bottom
Liners Used			Perf. top
			Perf. bottom

CASING CEMENTED	SIZE	No. Ft.	Date
COAL WAS ENCOUNTERED AT _____ FEET _____ INCHES			
_____ FEET	_____ INCHES	_____ FEET	_____ INCHES
_____ FEET	_____ INCHES	_____ FEET	_____ INCHES

Formation	Color	Hard or Soft	Top	Bottom	Oil, Gas or Water	Depth Found	Remarks
Conductor			0	15			
Sand			15	235			
COAL			235	240			
Slate			240	345			
Sand			345	374			
COAL			374	379	Water 375'		
Slate			379	530			
Lime			530	535			
Slate			535	740			
Sand			740	862			
Slate			862	963			
SALT SAND			963	1210	Gas 1210'-1220'		
Slate			1220	1270	Water 1180'		
SALT SAND			1270	1420	Water 1320'		
Red Rock			1420	1430			
Sand			1430	1495			
Red Rock			1495	1530			
Lime			1530	1560			
Red Rock			1560	1620			
Slate			1620	1631			
LITTLE LIME			1631	1660			
Slate			1660	1680			
Lime			1680	1692			
Pencil Cave			1692	1700			
BIG LIME			1700	1845			
Red Rock			1845	1862			
Red Sand			1862	1915			
White Sand (Wash)			1915	2070	Oil and Gas 2063'		
Slate			2070	2073			
Total Depth			2070	2073			

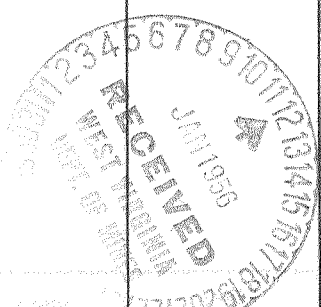

SHOT RECORD

DATE	SIZE SHOT	TOP SHELL
1/19/14	20	2062'
3/4/19	30	2060'
1/29/35	40	2062'