

Company	UNITED FUEL GAS CO.		
Address	CHARLESTON, W. VA.		
Farm	BLUE CREEK COAL & LAND CO.		
Tract	Acres	26,688	Lease No. 4881
Well (Farm) No.	Serial No.	526	
Elevation (Spirit Level)	1117.0 BAR.		
Quadrangle	CLEDENIN		
County	KANAWHA	District	ELK
Engineer	<i>Seibert R. Russell</i>		
Engineer's Registration No.	2529		
File No.	74-61	Drawing No.	
Date	2-29-56	Scale	1"=660'

STATE OF WEST VIRGINIA  
DEPARTMENT OF MINES  
OIL AND GAS DIVISION  
CHARLESTON

**WELL LOCATION MAP**  
FILE NO. KAN-1234-A

+ Denotes location of well on United States Topographic Maps, scale 1 to 62,500, latitude and longitude lines being represented by border lines as shown.

- Denotes one inch spaces on border line of original tracing.

6-6-216



1967

STATE OF WEST VIRGINIA  
DEPARTMENT OF MINES  
OIL AND GAS DIVISION

Quadrangle Chandlers

Permit No. 1234-A

WELL RECORD

Oil or Gas Well \_\_\_\_\_  
(KIND)


Company United Fuel Gas Company  
 Address Charleston, W. Va.  
 Farm Blue Creek Tract 75 Acres 26.658  
 Location (waters) \_\_\_\_\_  
 Well No. 526 Elev. 117' 0"  
 District Elk County Kanawha  
 The surface of tract is owned in fee by \_\_\_\_\_  
 Address \_\_\_\_\_  
 Mineral rights are owned by \_\_\_\_\_  
 Address \_\_\_\_\_  
 Drilling commenced November 7, 1913  
 Drilling completed March 21, 1914  
 Date Shot \_\_\_\_\_ From \_\_\_\_\_ To \_\_\_\_\_  
 With \_\_\_\_\_  
 Open Flow 12/10ths Water in 5-3/16" opening Inch  
 \_\_\_\_\_ /10ths Merc. in \_\_\_\_\_ Inch  
 Volume \_\_\_\_\_ Cu. Ft.  
 Rock Pressure \_\_\_\_\_ lbs. \_\_\_\_\_ hrs.  
 Oil \_\_\_\_\_ bbls., 1st 24 hrs.  
 Fresh water \_\_\_\_\_ feet \_\_\_\_\_ feet  
 Salt water \_\_\_\_\_ feet \_\_\_\_\_ feet

Casing and Tubing	Used in Drilling	Left in Well	Packers
Size			Kind of Packer
16			
13			
10	None		Size of
8 1/4	570'	570'	Depth set
6 5/8	1700'	1700'	
5 3/16	1759'	1759'	
3			Perf. top
2			Perf. bottom
Liners Used			Perf. top
			Perf. bottom

CASING CEMENTED \_\_\_\_\_ SIZE \_\_\_\_\_ No. Ft. \_\_\_\_\_ Date \_\_\_\_\_

COAL WAS ENCOUNTERED AT \_\_\_\_\_ FEET \_\_\_\_\_ INCHES  
 \_\_\_\_\_ FEET \_\_\_\_\_ INCHES \_\_\_\_\_ FEET \_\_\_\_\_ INCHES  
 \_\_\_\_\_ FEET \_\_\_\_\_ INCHES \_\_\_\_\_ FEET \_\_\_\_\_ INCHES

Formation	Color	Hard or Soft	Top	Bottom	Oil, Gas or Water	Depth Found	Remarks
Conductor				16			
Coal			400	403			
Coal			475	478			
Lime, Slate & Shells			478	1100			
Salt Sand			1100	1235	Water - hole full	1145'	
Slate & Lime			1235	1335			
Sand, Slate & Lime			1335	1512			
Red Rock			1512	1600			
Lime			1600	1615			
Red Rock			1615	1655			
Little Lime			1655	1670			
Slate & Shells			1670	1718			
Pencil Cave			1718	1734			
Big Lime			1734	1983	Gas (show)	1783'	
Red Rock			1983	2018			
Sand			2018	2084			
WEIR SAND			2084	2125			
Slate			2125	2175	Gas 2100'		
					Gas 2110'		
Total Depth				2175			

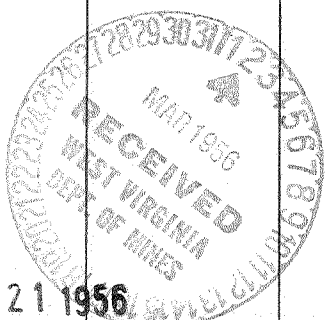

JUNE 21 1956