

New Location..
 Drill Deeper.....
 Abandonment.....

AUG. 6 1956

KAN-1240-A-#3
 KAN-1241-A-#9
 KAN-1242-A-#16
 KAN-1243-A-#18

Company RICHARD JACKSON
 Address CHARLESTON, W.VA.
 Farm C. B. GRAHAM
 Tract _____ Acres 700 Lease No. _____
 Well (Farm) No. 3, 9, 16 & 18 Serial No. F2405, F4189, F4781 & F4577
 Elevation (Spirit Level) #3-1091 - #9-948.2
#16-745 - #18-899
 Quadrangle CHARLESTON
 County KANAWHA District ELK
 Engineer PAUL E. JOACHIM
 Engineer's Registration No. 669
 File No. 68-59 Drawing No. _____
 Date 7-10-56 Scale 1"=1320'

STATE OF WEST VIRGINIA
 DEPARTMENT OF MINES
 OIL AND GAS DIVISION
 CHARLESTON

WELL LOCATION MAP

FILE NO. See Above

+ Denotes location of well on United States Topographic Maps, scale 1 to 62,500, latitude and longitude lines being represented by border lines as shown.

- Denotes one inch spaces on border line of original tracing.

C. B. GRAHAM NO. 3, 9, 16, & 18 - RICHARD JACKSON - KAN-1240-A - WVA-1242-A & 1243-A



1994

STATE OF WEST VIRGINIA
DEPARTMENT OF MINES
OIL AND GAS DIVISION

Charleston
Quadrangle

WELL RECORD

Permit No. Kan. 1240-A

Oil or Gas Well Oil
(KIND)

Company Wilhelm and Jackson (Richard Jackson)
Address Hamlin, West Virginia
Farm C. B. Graham Acres 700
Location (waters) 3
Well No. 1091 Elev. 1091
District Elk County Kanawha
The surface of tract is owned in fee by _____

Casing and Tubing	Used in Drilling	Left in Well	Packers
Size			Kind of Packer
16			
13			
10			Size of
8 1/4	497' 5"	Pulled	
6 3/4	1890' 3"	1890' 3"	Depth set
5 3/16			
3			Perf. top
2			Perf. bottom
Liners Used			Perf. top
			Perf. bottom

Mineral rights are owned by A. A. Graham Heirs
408 McKinson St. Address Charleston, W. Va.
August 11, 1916

Drilling commenced _____
Drilling completed October 10, 1916
Date Shot 10/11/16 In Well _____
With 120 qts.

Open Flow /10ths Water in _____ Inch
/10ths Merc. in _____ Inch

Volume _____ Cu. Ft.

Rock Pressure _____ lbs. _____ hrs.

Oil 16 _____ bbls., 1st 24 hrs.

Fresh water _____ feet _____ feet
Salt water _____ feet _____ feet


CASING CEMENTED _____ SIZE _____ No. Ft. _____ Date _____

COAL WAS ENCOUNTERED AT _____ FEET _____ INCHES

_____ FEET _____ INCHES _____ FEET _____ INCHES

_____ FEET _____ INCHES _____ FEET _____ INCHES

Formation	Color	Hard or Soft	Top	Bottom	Oil, Gas or Water	Depth Found	Remarks
Conductor			16				
Slate & Shells			15	400			
COAL			400	404			
Slate & Shells			404	1010			
Salt Sand			1010	1590	Water 1135		
Slate			1590	1620			
Sand			1620	1670			
Slate			1670	1685			
Naxon Sand			1685	1705			
Slate			1705	1720			
Little Lime			1720	1769			
Pencil Cave			1769	1774			
Big Lime			1774	1918	Water - Hole full - 1861'		
Big Injun			1918	1960	Water 1942'		
Sand			1960	1985			
Red Sand			1985	2000			
Broken Sand			2000	2163	Gas 2050'		
Weir Sand			2163	2208	Oil - first pay 2167-2171'		
					Oil - Second Pay 2200-2208'		
Total Depth				2216			

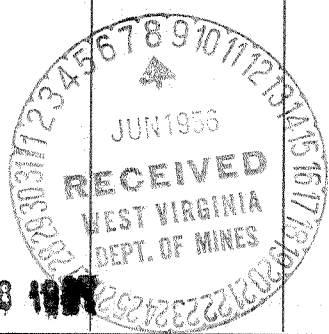

MAR 28 1936