

Company **RICHARD JACKSON**

Address **CHARLESTON, W.VA.**

Farm **J.V.R. SKINNER**

Tract \_\_\_\_\_ Acres **346** Lease No. \_\_\_\_\_

Well (Farm) No. **3** Serial No. **F-1799**

Elevation (Spirit Level) **955.5'**

Quadrangle **CLENDENIN**

County **KANAWHA** District **ELK**

Engineer **PAUL E. JOACHIM**

Engineer's Registration No. **669**

File No. **72-63** Drawing No. \_\_\_\_\_

Date **7-9-56** Scale **1"=800'**

STATE OF WEST VIRGINIA  
DEPARTMENT OF MINES  
OIL AND GAS DIVISION  
CHARLESTON

**WELL LOCATION MAP**  
FILE NO. **KAN-1244-A**

+ Denotes location of well on United States Topographic Maps, scale 1 to 62,500, latitude and longitude lines being represented by border lines as shown.

- Denotes one inch spaces on border line of original tracing.

6-6 218

J.V.R. SKINNER NO. 3 (F-1799) - RICHARD JACKSON - KAN-1244-A



2004

STATE OF WEST VIRGINIA  
DEPARTMENT OF MINES  
OIL AND GAS DIVISION

Quadrangle Clendenin

WELL RECORD

Permit No. Kan. 1244-A

Oil or Gas Well \_\_\_\_\_  
(KIND)


Company Wilhelm and Jackson (Richard Jackson)  
 Address Hemlin, W. Va.  
 Farm J. V. R. Skinner Acres 346  
 Location (waters) \_\_\_\_\_  
 Well No. 3 (F-1799) Elev. 955.5  
 District 21k County Kanawha  
 The surface of tract is owned in fee by J. V. R. Skinner Mrs.  
St. Albans, W. Va. Address \_\_\_\_\_  
 Mineral rights are owned by Same  
 Address \_\_\_\_\_  
 Drilling commenced March 21, 1914  
 Drilling completed May 6, 1914  
 Date Shot 1914-17 & 22 From Wair Sand To \_\_\_\_\_  
 With \_\_\_\_\_  
 Open Flow \_\_\_\_\_ /10ths Water in \_\_\_\_\_ Inch  
 \_\_\_\_\_ /10ths Merc. in \_\_\_\_\_ Inch  
 Volume \_\_\_\_\_ Cu. Ft.  
 Rock Pressure \_\_\_\_\_ lbs. \_\_\_\_\_ hrs.  
 Oil 125 bbls., 1st 24 hrs.  
 Fresh water \_\_\_\_\_ feet \_\_\_\_\_ feet  
 Salt water \_\_\_\_\_ feet \_\_\_\_\_ feet

Casing and Tubing	Used in Drilling	Left in Well	Packers
Size			
16			Kind of Packer
13			
10			Size of
8 1/4	<u>611'</u>	<u>Pulled</u>	
6 5/8	<u>1704'</u>	<u>1704'</u>	Depth set
5 3/16	<u>2010'</u>	<u>Pulled</u>	
3			Perf. top
2			Perf. bottom
Liners Used			Perf. top
			Perf. bottom

CASING CEMENTED \_\_\_\_\_ SIZE \_\_\_\_\_ No. Ft. \_\_\_\_\_ Date \_\_\_\_\_

COAL WAS ENCOUNTERED AT \_\_\_\_\_ FEET \_\_\_\_\_ INCHES  
 \_\_\_\_\_ FEET \_\_\_\_\_ INCHES FEET \_\_\_\_\_ INCHES  
 \_\_\_\_\_ FEET \_\_\_\_\_ INCHES FEET \_\_\_\_\_ INCHES

Formation	Color	Hard or Soft	Top	Bottom	Oil, Gas or Water	Depth Found	Remarks
Conductor				16			
Slate & Shells			16	150			
Sand			150	200			
Slate & Shells			200	250			
Sand			250	400			
Slate & Shells			400	450			
COAL			450	455			
Slate			455	470			
Sand			470	600			
Slate			600	620			
Sand			620	700			
Slate & Shells			700	980			
SALT SAND			980	1485			
Slate & Red Rock			1485	1535			
Slate & Shells			1535	1600			
MAKON SAND			1600	1615			
Slate			1615	1625			
LITTLE LIME			1625	1650			
Slate & Lime Shells			1650	1673			
Pencil Slate			1673	1688			
BIG LIME			1688	1800	Gas 1730'		
BIG INJUN			1800	1810	Gas 1828'		
Slate & Lime			1810	1880			
Sand			1880	1910	Gas 1935'		
Slate & Sand			1910	1975	Gas 1958'		
Slate			1975	1985			
WHR SAND			1985	2089	Oil & Gas 2055'		
					Oil & Gas 2075'		
					Oil & Gas 2079 to 2081'		
Total Depth				2089			

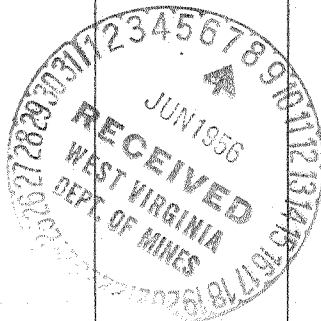

MAR. 28 1957