

Surface:
Virgil Mullins
Quick, W. Va.

Coal:
Carbide & Carbon Chem. Corp.
1106 Security Bldg.
Charleston, W. Va.

New Location...
 Drill Deeper.....
 Abandonment.....

DEC. 5 1956 S 71 W 44 Map 101

Company	South Penn Natural Gas Co.
Address	Parkersburg, W. Va.
Farm	Blue Creek Coal & Land Co.
Tract	Acres 29,768 Lease No. 57822
Well (Farm) No.	9 Serial No.
Elevation (Spirit Level)	1239.08 Casinghead
Quadrangle	Clendenin
County	Kanawha District ELK
Engineer	Mrs. S. Hayes
Engineer's Registration No.	1A-29
File No.	Drawing No.
Date	Oct. 16, 1956 Scale 1" = 400'

STATE OF WEST VIRGINIA
 DEPARTMENT OF MINES
 OIL AND GAS DIVISION
 CHARLESTON

WELL LOCATION MAP
 FILE NO. KAN-1249-A

+ Denotes location of well on United States Topographic Maps, scale 1 to 62,500, latitude and longitude lines being represented by border lines as shown.

- Denotes one inch spaces on border line of original tracing.

BLUE CREEK COAL & LAND CO. No. 9 - SOUTH PENN N.G. Co. - KAN-1249-A



STATE OF WEST VIRGINIA
DEPARTMENT OF MINES
OIL AND GAS DIVISION

1989

Clemson

WELL RECORD

Permit No. 1299-A

Oil or Gas Well Oil
(KIND)


Company SOUTH FARM NATURAL GAS COMPANY
 Address P. O. Box 1289, Parkersburg, W. Va.
 Farm Blue Creek Tract Acres 2768
 Location (waters) Blue Creek
 Well No. 9 Elev. 1239.08
 District 11k County Kanawha
 The surface of tract is owned in fee by Virgil Mullins
 Address Quaker, W. Va.
 Mineral rights are owned by Carbide & Carbon
Chemicals Corp. Address Charleston, W. Va.
 Drilling commenced Oct. 29, 1912
 Drilling completed Jan. 8, 1913
 Date Shot 4 Times in help sand From _____ To _____
 With _____
 Open Flow _____ /10ths Water in _____ Inch
 _____ /10ths Merc. in _____ Inch
 Volume _____ Cu. Ft.
 Rock Pressure _____ lbs. _____ hrs.
 Oil _____ 500 bbls., 1st 24 hrs.
 Fresh water 1295' feet 1315' feet
 Salt water _____ feet _____ feet

Casing and Tubing	Used in Drilling	Left in Well	Packers
Size			Kind of Packer
16			
13			
10			Size of
8 1/4	<u>873'</u>	<u>873'</u>	
6 1/2	<u>1928'</u>	<u>1928'</u>	Depth set
5 3/16			
3			Perf. top
2			Perf. bottom
Liners Used			Perf. top
			Perf. bottom

CASING CEMENTED _____ SIZE _____ No. Ft. _____ Date _____

SEE RECORD BELOW AS TO COAL
 COAL WAS ENCOUNTERED AT _____ FEET _____ INCHES
 _____ FEET _____ INCHES _____ FEET _____ INCHES
 _____ FEET _____ INCHES _____ FEET _____ INCHES

Formation	Color	Hard or Soft	Top	Bottom	Oil, Gas or Water	Depth Found	Remarks
Conductor				15			
Sand & slate			15	30			
Sand			30	65			
Slate			65	125			
Sand			125	150			
Slate			150	220			
Coal			220	223			
Sand			223	270			
Slate			270	285			
lime			285	400			
sand			400	415			
Slate			415	448			
Coal			448	456			
Sand			456	480			
lime			480	504			
Coal			504	507			
lime			507	583			
Coal			583	590			
Slate			590	600			
Slate & Shells			600	762			
Coal			762	766			
Slate			766	800			
lime			800	834			
Coal			834	838			
Slate & Shells			838	880			
Sand			880	897			
Slate			897	912			
Coal			912	914			
Sand			914	1000			
Slate & Shells			1000	1105			
Sand			1105	1160			
Slate & Lime			1160	1171			
Sand			1171	1220			
Slate			1220	1230			
Salt Sand			1230	1400			
					Water	1295	
					Gas	1312	

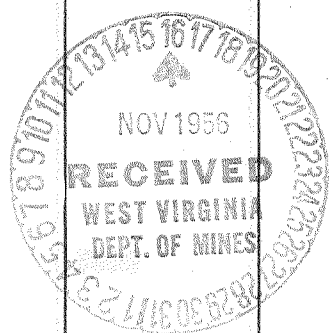

(CONTINUED ON OTHER SIDE) MAY 28 1957

Formation	Color	Hard or Soft	Top	Bottom	Oil, Gas or Water	Depth Found	Remarks		
(CONTINUED FROM OTHER SLIP)									
Lime			1400	1435	Water	1315	Hole Full		
Sand			1435	1495					
Lime			1495	1515					
Sand			1515	1690					
Slate			1690	1700					
Red Rock			1700	1785					
Lime			1785	1790					
Marion Sand			1790	1825					
Slate			1825	1830				Gas shale	1800
Lime			1830	1858					
Slate & Shells			1858	1865					
Lime			1865	1897					
Pennell Cave			1897	1900					
Big Lime			1900	2052					
Red Rock			2052	2080					
Big Injan Sand			2080	2155					
Slate			2155	2160					
Mar Sand			2160	2269	Oil & Gas	2260-2269			
TOTAL DEPTH				2270					

MATT BEGOWD

Date October 26th, 1956

APPROVED SEVEN PINE NATURAL GAS COMPANY, Owner

By George W. Williams
(Title)
George W. Williams, Land Agent