

New Location...
 Drill Deeper.....
 Abandonment.....

Coal: ^{DEC 5 1958} Carbide & Carbon Chem. Corp.
 1106 Security Bldg.
 Charleston, W. Va. S 71 W 44 Map 101

Company South Penn Natural Gas Co.
 Address Parkersburg, W. Va.
 Farm Blue Creek Coal & Land Co.
 Tract _____ Acres 29.768 Lease No. 57822
 Well (Farm) No. 24 Serial No. _____
 Elevation (Spirit Level) 1191.78 casinghead
 Quadrangle Clendenin
 County Kanawha District Elk
 Engineer Wm. A. Hayes
 Engineer's Registration No. 1429
 File No. _____ Drawing No. _____
 Date Oct. 23, 1956 Scale 1" = 400'

STATE OF WEST VIRGINIA
 DEPARTMENT OF MINES
 OIL AND GAS DIVISION
 CHARLESTON

WELL LOCATION MAP
 FILE NO. KAN-1250-A

+ Denotes location of well on United States Topographic Maps, scale 1 to 62,500, latitude and longitude lines being represented by border lines as shown.
 - Denotes one inch spaces on border line of original tracing.

6-6-218



1990

STATE OF WEST VIRGINIA
DEPARTMENT OF MINES
OIL AND GAS DIVISION

WELL RECORD

Permit No. Ken 1256-A

Oil or Gas Well Oil
(KIND)


Company SOUTH PENN NATURAL GAS COMPANY
Address P. O. Box 1280, Parkersburg, W. Va.
Farm Blue Creek Tract Acres 29768
Location (waters) Blue Creek
Well No. 24 Elev. 1191.76
District 13k County Kanawha
The surface of tract is owned in fee by Mrs. W. W. Hutson
Address Quick, W. Va.
Mineral rights are owned by Carbide & Carbon
Chemicals Corp. Address Charleston, W. Va.
Drilling commenced Aug. 5, 1913
Drilling completed Oct. 10, 1913
Date Shot 2 Times in Weir Sand From To
With

Casing and Tubing	Used in Drilling	Left in Well	Packers
Size			Kind of Packer
16			
18			
10			Size of
8 1/4	770'	770'	
6 5/8	1658'	1658'	Depth set
5 3/16			
3			Perf. top
2			Perf. bottom
Liners Used			Perf. top
			Perf. bottom

Open Flow /10ths Water in _____ Inch
/10ths Merc. in _____ Inch
Volume _____ Cu. Ft.
Rock Pressure _____ lbs. _____ hrs.
Oil 377 bbls., 1st 24 hrs.
Fresh water 530 feet 1290 feet
Salt water 1480 feet _____ feet

CASING CEMENTED _____ SIZE _____ No. Ft. _____ Date _____
COAL WAS ENCOUNTERED AT 390 FEET 48 INCHES
530 FEET 60 INCHES FEET INCHES
FEET INCHES FEET INCHES

Formation	Color	Hard or Soft	Top	Bottom	Oil, Gas or Water	Depth Found	Remarks
Conductor				16			
Coal			390	394			
Line & Sand			394	530	Water	530	
Coal			530	535			
Line & Sand			535	765			
Line			765	975			
Slate & Shells			975	1055			
Salt Sand			1055	1655	Gas Water	1170 1290 1480	Hole Full
Break			1425	1450			
Red Rock			1655	1700			
Slate & Shells			1700	1760			
Haxon Sand			1760	1780			
Break			1780	1790			
Little Line			1790	1828			
Break			1828	1834			
Line Shells			1834	1837			
Pencil Cave			1837	1844			
Big Line			1844	2004			
Slate			2004	2010			
Red Rock			2010	2090			
Sand			2090	2195			
Weir Sand			2195	2224	Oil & Gas	2215-2222	
TOTAL DEPTH				2224			

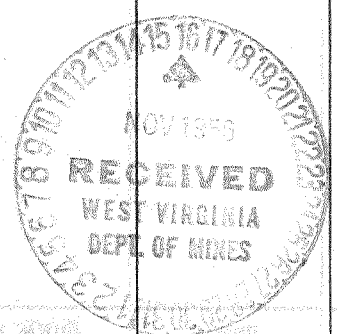

MAR 28 1957

