

New Location...   
 Drill Deeper.....   
 Abandonment.....

DEC. 21 1956

Company KREBS OIL COMPANY  
 Address BOX 213 - CHARLESTON, W. VA.  
 Farm MICHIE & MEADOWS  
 Tract 1 Acres 2.63 Lease No. 1  
 Well (Farm) No. 1 Serial No. \_\_\_\_\_  
 Elevation (Spirit Level) 824'  
 Quadrangle CLENDENIN  
 County KANAWHA District BIG SANDY  
 Engineer E. E. Krebs  
 Engineer's Registration No. 773  
 File No. \_\_\_\_\_ Drawing No. \_\_\_\_\_  
 Date 10-2-56 Scale 1" = 100'

STATE OF WEST VIRGINIA  
 DEPARTMENT OF MINES  
 OIL AND GAS DIVISION  
 CHARLESTON

WELL LOCATION MAP  
 FILE NO. KAN-1253-A

+ Denotes location of well on United States Topographic Maps, scale 1 to 62,500, latitude and longitude lines being represented by border lines as shown.

- Denotes one inch spaces on border line of original tracing.



2017

STATE OF WEST VIRGINIA  
DEPARTMENT OF MINES  
OIL AND GAS DIVISION

Quadrangle Clendenin

WELL RECORD

Permit No. 1253-A


Oil or Gas Well OIL  
(KIND)

Company Krebs Oil Company  
 Address Box #213, Charleston, W. Va.  
 Farm Michie Meadows Acres 2.63  
 Location (waters) Elk River  
 Well No. 1 Elev. 824'  
 District Big Sandy County Kanawha  
 The surface of tract is owned in fee by Kan. Valley Bank, Trustee, Peter Silman Address Charleston, W. Va.  
 Mineral rights are owned by Kan. Valley Bk. Trustee, Peter Silman Estate Address Charleston, W. Va.  
 Drilling commenced \_\_\_\_\_  
 Drilling completed March 9, 1921  
 Date Shot Unknown From \_\_\_\_\_ To \_\_\_\_\_  
 With \_\_\_\_\_  
 Open Flow \_\_\_\_\_ /10ths Water in \_\_\_\_\_ Inch  
 \_\_\_\_\_ /10ths Merc. in \_\_\_\_\_ Inch  
 Volume Unknown - Small Oil Well Cu. Ft. \_\_\_\_\_  
 Rock Pressure \_\_\_\_\_ lbs. \_\_\_\_\_ hrs.  
 Oil \_\_\_\_\_ bbls., 1st 24 hrs.  
 Fresh water \_\_\_\_\_ feet \_\_\_\_\_ feet  
 Salt water \_\_\_\_\_ feet \_\_\_\_\_ feet

Casing and Tubing	Used in Drilling	Left in Well	Packers
Size			Kind of Packer _____
16			
13			
10			Size of _____
8 1/4	<u>390'</u>		
6 5/8	<u>1690'</u>		Depth set _____
5 3/16			
3			Perf. top _____
2			Perf. bottom _____
Liners Used			Perf. top _____
			Perf. bottom _____

CASING CEMENTED \_\_\_\_\_ SIZE \_\_\_\_\_ No. Ft. \_\_\_\_\_ Date \_\_\_\_\_  
 COAL WAS ENCOUNTERED AT \_\_\_\_\_ FEET \_\_\_\_\_ INCHES  
 \_\_\_\_\_ FEET \_\_\_\_\_ INCHES \_\_\_\_\_ FEET \_\_\_\_\_ INCHES  
 \_\_\_\_\_ FEET \_\_\_\_\_ INCHES \_\_\_\_\_ FEET \_\_\_\_\_ INCHES

Formation	Color	Hard or Soft	Top	Bottom	Oil, Gas or Water	Depth Found	Remarks
Surface			00	15			
Sand			15	34			
Slate			34	76			
Sand			76	120			
Slate			120	180			
Sand			180	238			
Slate			238	294			
Lime			294	315			
Sand			315	350			
Slate			350	380			
Sand			380	400			
Slate			400	454			
Sand			454	500			
Slate			500	550			
Sand			550	574			
Slate			574	590			
Sand			590	616			
Slate			616	630			
Sand			630	700			
Slate			700	730			
Sand			730	770			
Slate			770	790			
Lime			790	840			
Slate			840	1075			
Gas Sand			1075	1100			
Slate			1100	1105			
Salt Sand			1105	1445			
Slate			1444	1455			
Lime			1455	1470			
Slate			1470	1505			

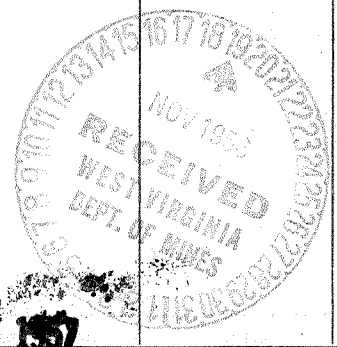

JUN 20 1957

Formation	Color	Hard or Soft	Top	Bottom	Oil, Gas or Water	Depth Found	Remarks
Maxon Sand			1505	1635			
Little Lime			1635	1665			
Slate			1665	1670			
Lime Shell			1670	1680			
Pencil Cave			1680	1685			
Big Lime			1685	1805			
Big Injun			1805	1835			
Slate and Shell			1835	1916			
Weir Sand			1916	2055			
Black Lime			2055	2058			
TOTAL DEPTH				-----		2058'	
Gas Pays -			1805' 7/10 in 1" - Big Injun				
"			2000' - 14/10" in 1" - Weir				
"			2015' - 28/10 in 1" - Weir				
Oil Pays show -		1920' - Black					
Oil - Light		2015'					
Oil - Regular		2024' - 2032'					
		2042' - 2052'					
Salt Water at		1155'					

Date November 16, 19 56

APPROVED KREBS OIL COMPANY, Owner

By B. E. Krebs  
(Title) President

6-14-55  
10-1-56  
10-1-56