



Latitude 38° 30'

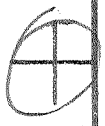

0.685
0.2 W

Longitude 81° 20'

ELK RIVER

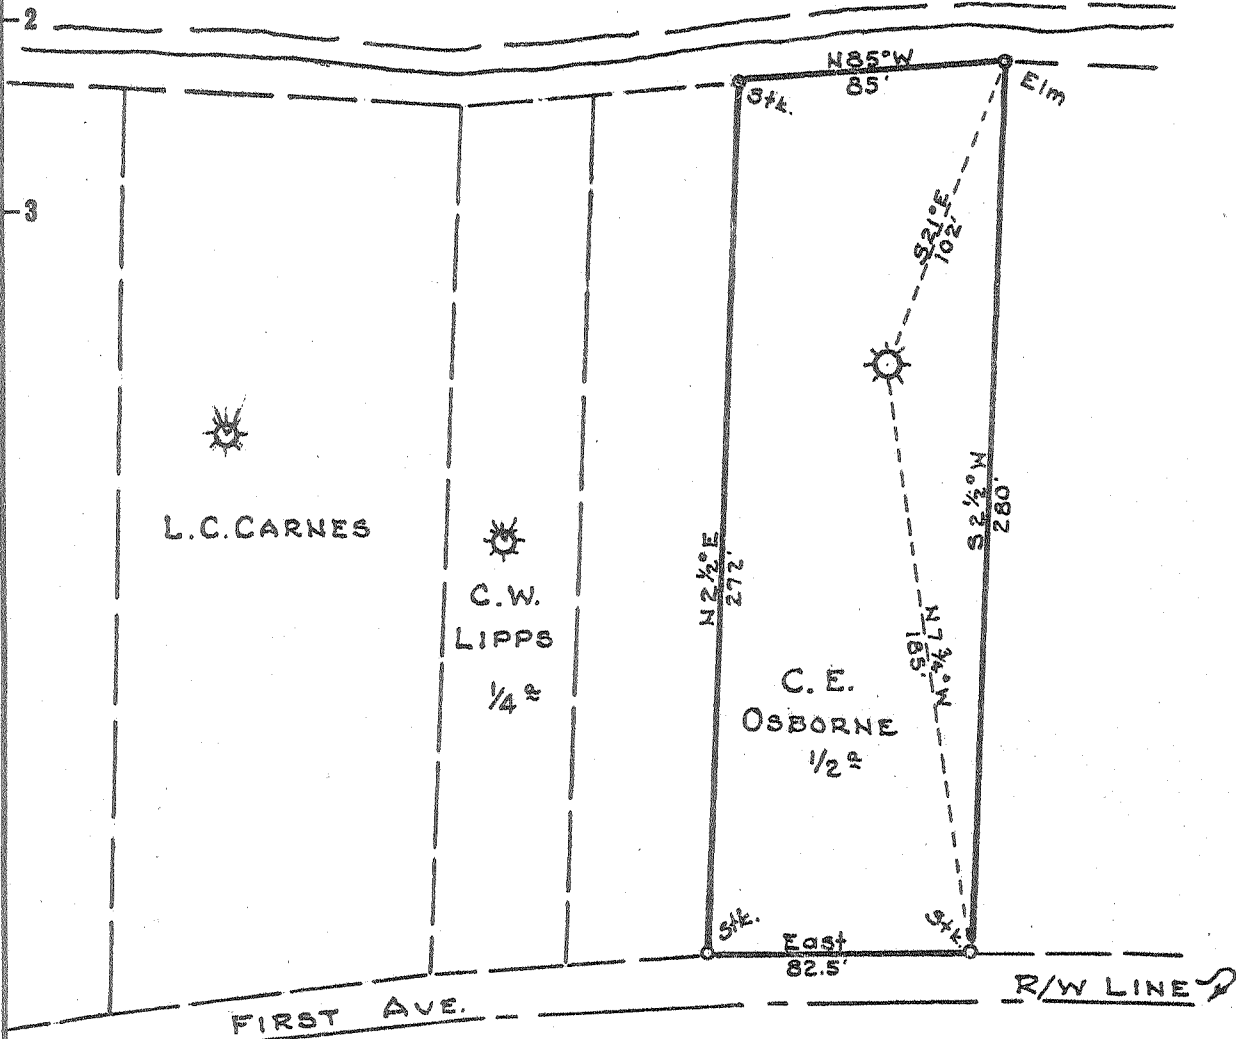

New Location
 Drill Deeper
 Abandonment

AUG 21 1957

0.2 W
0.7

Company FISHER GAS CO.
 Address CLENDENIN, W. VA.
 Farm C. E. OSBORNE
 Tract _____ Acres 1/2 Lease No. _____
 Well (Farm) No. 1 Serial No. F5890
 Elevation (Spirit Level) 625.8'
 Quadrangle CLENDENIN
 County KANAWHA District BIG SANDY
 Engineer PAUL E. JOACHIM
 Engineer's Registration No. 669
 File No. 76-69 Drawing No. _____
 Date JULY 29, 1957 Scale 1" = 60'

STATE OF WEST VIRGINIA
 DEPARTMENT OF MINES
 OIL AND GAS DIVISION
 CHARLESTON

WELL LOCATION MAP
 FILE NO. KAN-1262-A

+ Denotes location of well on United States Topographic Maps, scale 1 to 62,500, latitude and longitude lines being represented by border lines as shown.

-- Denotes one inch spaces on border line of original tracing.

6-0 220

WEST VIRGINIA DEPARTMENT OF MINES
OIL AND GAS DIVISION

WV

WELL RECORD

Clendenin
Ab 1-262-A

Oil or Gas Well 500
(Kind)

Company Fisher Gas Company
 Address Box 156 Clendenin, W. Va.
 Farm G. E. Osborne Acres 1/2
 Location (waters) Elk River
 Well No. 1 Elev. 625.8'
 District Big Sandy County Kanawha
 The surface of tract is owned in fee by G. E. Osborne
 Address Clendenin, W. Va.
 Mineral rights are owned by Same
 Address _____
 Drilling commenced 1924
 Drilling completed 1924
 Date shot _____ Depth of shot _____
 Open Flow /10ths Water in _____ Inch
/10ths Merc. in _____ Inch
 Volume _____ Cu. Ft.
 Rock Pressure _____ lbs. _____ hrs.
 Oil _____ bbls., 1st 24 hrs.
 Fresh water _____ feet _____ feet
 Salt water _____ feet _____ feet

Casing and Tubing	Used in Drilling	Left in Well	Packers
Size			
16			Kind of Packer
13			
10	62'	62'	Size of
8 1/4	300'		
6 5/8	1297'	1297'	Depth set
5 3/16			
3	1659'	1659'	Perf. top
2			Perf. bottom
Liners Used			Perf. top
			Perf. bottom

CASING CEMENTED _____ SIZE _____ No. FT. _____ Date _____
 _____ No _____
 COAL WAS ENCOUNTERED AT _____ FEET _____ INCHES
 _____ FEET _____ INCHES _____ FEET _____ INCHES
 _____ FEET _____ INCHES _____ FEET _____ INCHES

Formation	Color	Hard or Soft	Top	Bottom	Oil Gas or Water	Depth Found	Remarks
Sand & Gravel			0	75			
Slate & Slate			75	375			
Sand			375	400			
Slate			400	465			
Sand			465	525			
Slate & Shells			525	745			
Salt Sand			745	900			
Slate			900	1020			
Black Lime			1020	1090			
Maxin Sand			1090	1240			
Little Lime			1240	1274			
Sand & Shell			1274	1282			
Slate			1282	1287			
Sand & Shell			1287	1293			
Pencil Cave			1293	1296			
Big Lime			1296	1410			
Big Injun			1410	1448			
Red Line			1448	1469			
Slate & Shell			1469	1502	First Gas in Weir		1510
Wier Sand			1502	1654	2nd " " "		1610
Slate			1654	1661	3rd " " "		1647
Total Depth				1661			

(Handwritten circle)

AUG 1957
RECEIVED
WEST VIRGINIA
DEPT. OF MINES

AUG 1957
RECEIVED
WEST VIRGINIA
DEPT. OF MINES

DEC 6 1957

