

Company Godfrey L. Cabot Inc.  
 Address Box 1473 Charleston W.Va.  
 Farm Amherst Coal Co.  
 Tract \_\_\_\_\_ Acres 270 Lease No. 4-58  
 Well (Farm) No. 1 Serial No. 668  
 Elevation (Spirit Level) 649.0  
 Quadrangle Charleston  
 County Manawha District Malden  
 Engineer Roy Boston  
 Engineer's Registration No. 3204  
 File No. \_\_\_\_\_ Drawing No. \_\_\_\_\_  
 Date 4-25-58 Scale 1" = 1320'

STATE OF WEST VIRGINIA  
 DEPARTMENT OF MINES  
 OIL AND GAS DIVISION  
 CHARLESTON

WELL LOCATION MAP  
 FILE NO. KAN-1267-A

+ Denotes location of well on United States Topographic Maps, scale 1 to 62,500, latitude and longitude lines being represented by border lines as shown.

- Denotes one inch spaces on border line of original tracing.

6-6214

AMHERST COAL CO. No. 1 (668) - G.L. CABOT, JR. - KAN-1267-A



7034

STATE OF WEST VIRGINIA  
DEPARTMENT OF MINES  
OIL AND GAS DIVISION

Quadrangle Charleston

Permit No. 1267-K

WELL RECORD

Oil or Gas Well GAS  
(KIND)

Company Godfrey L. Cabot, Inc.  
Address Charleston, W. Va.  
Farm Amherst Coal Co. Acres 270  
Location (waters) \_\_\_\_\_  
Well No. 1, Serial 628 (668) Elev. 649  
District Malden County Kanawha  
The surface of tract is owned in fee by \_\_\_\_\_  
Address \_\_\_\_\_  
Mineral rights are owned by Amherst Coal Co.  
Address Port Amherst, W. Va.

Drilling commenced \_\_\_\_\_  
Drilling completed 1916  
Date Shot From \_\_\_\_\_ To \_\_\_\_\_  
With \_\_\_\_\_  
Open Flow /10ths Water in \_\_\_\_\_ Inch  
/10ths Merc. in \_\_\_\_\_ Inch  
Volume 2440 Mcf Cu. Ft.  
Rock Pressure \_\_\_\_\_ lbs. \_\_\_\_\_ hrs.  
Oil \_\_\_\_\_ bbls., 1st 24 hrs.  
WELL ACIDIZED \_\_\_\_\_  
WELL FRACTURED \_\_\_\_\_


Casing and Tubing	Used in Drilling	Left in Well	Packers
Size			Kind of Packer
16			
13			
10			Size of
8 1/4			
6 5/8			Depth set
5 3/16	1226	1226	
3			Perf. top
2			Perf. bottom
Liners Used			Perf. top
			Perf. bottom

CASING CEMENTED \_\_\_\_\_ SIZE \_\_\_\_\_ No. Ft. \_\_\_\_\_ Date \_\_\_\_\_

COAL WAS ENCOUNTERED AT \_\_\_\_\_ FEET \_\_\_\_\_ INCHES  
\_\_\_\_\_ FEET \_\_\_\_\_ INCHES FEET \_\_\_\_\_ INCHES  
\_\_\_\_\_ FEET \_\_\_\_\_ INCHES FEET \_\_\_\_\_ INCHES

RESULT AFTER TREATMENT \_\_\_\_\_  
ROCK PRESSURE AFTER TREATMENT \_\_\_\_\_  
Fresh Water \_\_\_\_\_ Feet Salt Water \_\_\_\_\_ Feet

Formation	Color	Hard or Soft	Top	Bottom	Oil, Gas or Water	Depth	Remarks
Big Lime		1078	1259		Gas	1123-58	440 Mcf
Ingum		1268	1294		Gas	1268-82	2,000 Mcf
Shale & Shell		1294	1712				
NOTE: Gas practically exhausted and hole making water--April 1958.							
NO OTHER INFORMATION AVAILABLE							

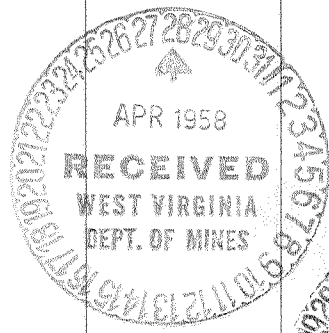


(over) DEC 20 1958

Formation	Color	Hard or Soft	Top	Bottom	Oil, Gas or Water	Depth Found	Remarks

Date April 25, 1958

APPROVED GODFREY L. CABOT, INC., Owner

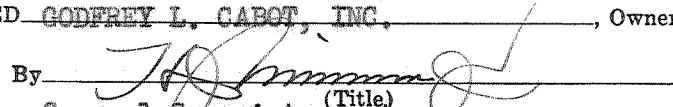By  (Title)  
**General Superintendent**