

New Location
 Drill Deeper
 Abandonment

JAN 26 1959

Company	BLUE CREEK GAS CO.
Address	CHARLESTON, W. VA.
Farm	JAMES KUHN
Tract	Acres 3 Lease No.
Well (Farm) No.	1 Serial No.
Elevation (Spirit Level)	635.00 GR.
Quadrangle	PEYTONA
County	KANAWHA District MALDEN
Engineer	PAUL E. JOACHIM
Engineer's Registration No.	669
File No.	66-51 Drawing No.
Date	JAN. 10, 1959 Scale 1" = 100'

STATE OF WEST VIRGINIA
 DEPARTMENT OF MINES
 OIL AND GAS DIVISION
 CHARLESTON

WELL LOCATION MAP

FILE NO. KAN-1276-A

+ Denotes location of well on United States Topographic Maps, scale 1 to 62,500, latitude and longitude lines being represented by border lines as shown.

- Denotes one inch spaces on border line of original tracing.



2241

STATE OF WEST VIRGINIA
DEPARTMENT OF MINES
OIL AND GAS DIVISION

Quadrangle Keyton

WELL RECORD

Permit No. None 1276A


Oil or Gas Well Gas
(KIND)

Company Blue Creek Gas Co.
 Address 1710 Penn. Ave. (Kinn-Conn)
 Farm James S. Coon (Kinn-Conn) Acres 3.2
 Location (waters) _____
 Well No. 1 Elev. 635 (9)
 District Malden County Kanawha
 The surface of tract is owned in fee by James S. Coon & Taena Coon
 Address Belle, W. Va.
 Mineral rights are owned by James S. & Taena Coon
 Address Belle, W. Va.
 Drilling commenced May 4, 1929
 Drilling completed Sept. 4, 1929
 Date Shot 8/28/29 From 1370 To 1380
 With _____
 Open Flow 2 /10ths Water in 2" Inch
 _____ /10ths Merc. in _____ Inch
 Volume 60 Cu. Ft.
 Rock Pressure _____ lbs. _____ hrs.
 Oil _____ bbls., 1st 24 hrs.
 Fresh water _____ feet _____ feet
 Salt water _____ feet _____ feet

Casing and Tubing	Used in Drilling	Left in Well	Packers
Size			Kind of Packer
16			
13			
10			Size of
8 1/4			
6 5/8			Depth set
5 3/16			
3			Perf. top
2			Perf. bottom
Liners Used			Perf. top
			Perf. bottom

CASING CEMENTED _____ SIZE _____ No. Ft. _____ Date _____
 COAL WAS ENCOUNTERED AT _____ FEET _____ INCHES
 _____ FEET _____ INCHES _____ FEET _____ INCHES
 _____ FEET _____ INCHES _____ FEET _____ INCHES

Formation	Color	Hard or Soft	Top	Bottom	Oil, Gas or Water	Depth Found	Remarks
Big Lime			1060	1370			
Keener			1370	1405			

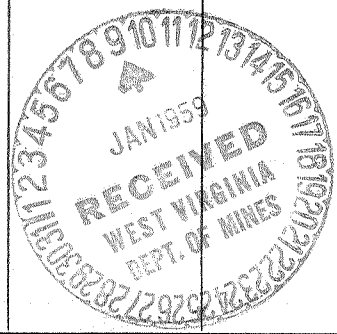

JUL 23 1959