


Latitude 38° 30'

Longitude 81° 20'

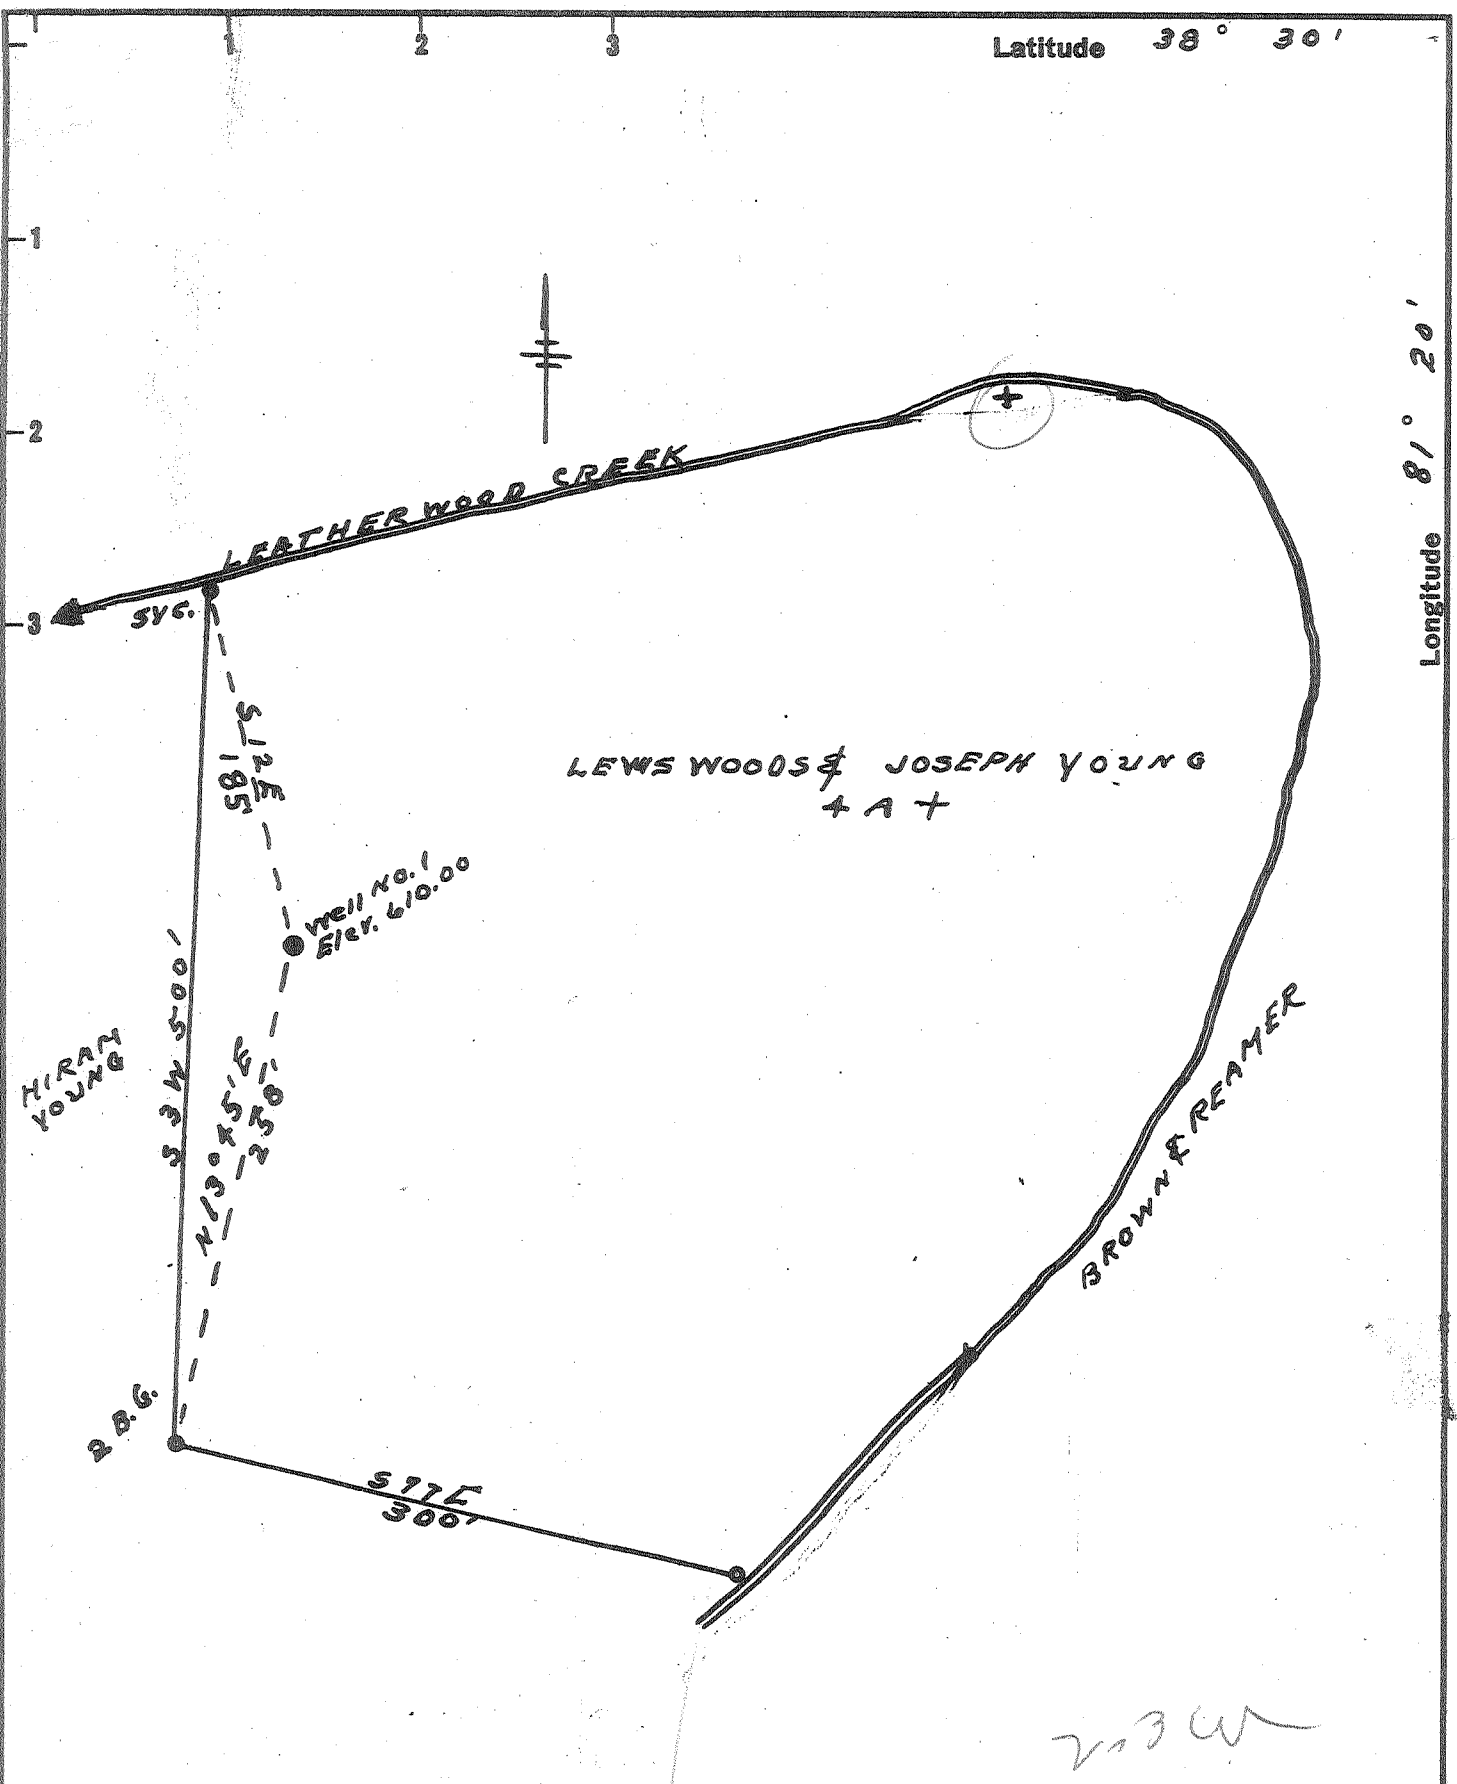

New Location
 Drill Deeper
 Abandonment

FEB 16 1959

2.3 W
 2.0 A

Company REX OIL & GAS CO.
 Address CLENDENNIN, W.VA
 Farm LEWIS WOODS & JOSEPH YOUNG
 (S.H. Blackwell)
 Tract _____ Acres 4A+ Lease No. _____
 Well (Farm) No. 1 Serial No. _____
 Elevation (Spirit Level) 610.00
 Quadrangle CLENDENNIN
 County KANAWHA District BIG SANDY
 Engineer L. J. Dye
 Engineer's Registration No. 804
 File No. _____ Drawing No. _____
 Date 1-27-59 Scale 1" = 100'

STATE OF WEST VIRGINIA
 DEPARTMENT OF MINES
 OIL AND GAS DIVISION
 CHARLESTON

WELL LOCATION MAP

FILE NO. KAN-1280-A

+ Denotes location of well on United States Topographic Maps, scale 1 to 62,500, latitude and longitude lines being represented by border lines as shown.

- Denotes one inch spaces on border line of original tracing.

6-0279



Handwritten initials/signature

STATE OF WEST VIRGINIA
DEPARTMENT OF MINES
OIL AND GAS DIVISION

Quadrangle Clendenin
Permit No. 1280-A

WELL RECORD

Oil or Gas Well Gas & Oil
(KIND)

Company Rex Oil and Gas Company
Address Clendenin, West Virginia
Farm Lewis Wood & Joseph Young / Blackwell Acres 4
Location (waters) Leatherwood Creek
Well No. 1 Elev. 610'
District Big Sandy County Kanawha
The surface of tract is owned in fee by _____
Address _____
Mineral rights are owned by _____
Address _____
Drilling commenced _____
Drilling completed 7/27/1917
Date Shot _____ From _____ To _____
With _____
Open Flow /10ths Water in _____ Inch
/10ths Merc. in _____ Inch
Volume _____ Cu. Ft.
Rock Pressure _____ lbs. _____ hrs.
Oil _____ bbls., 1st 24 hrs.
WELL ACIDIZED _____
WELL FRACTURED _____

Casing and Tubing	Used in Drilling	Left in Well	Packers
Size			
16			Kind of Packer
13			
10			Size of
8 1/4			
6 5/8	1329	1329	Depth set
5 3/16	1390	1390	
3			Perf. top
2	1705	---	Perf. bottom
Liners Used			Perf. top
			Perf. bottom

CASING CEMENTED _____ SIZE _____ No. Ft. _____ Date _____

COAL WAS ENCOUNTERED AT _____ FEET _____ INCHES
_____ FEET _____ INCHES FEET _____ INCHES
_____ FEET _____ INCHES FEET _____ INCHES

RESULT AFTER TREATMENT _____
ROCK PRESSURE AFTER TREATMENT _____
Fresh Water _____ Feet Salt Water _____ Feet

Formation	Color	Hard or Soft	Top	Bottom	Oil, Gas or Water	Depth	Remarks
Top of Big Lime			1312				
Top of Injun <i>font</i>			1460d	1490	Gas	1465'	
Top of Weir <i>font</i>			1600		Gas in Weir	1660'	
Reduced to 5-3/16" hole					Light show oil	1685 to 1690	
Bottom of Sand				1700			
Total Depth				1705			

AUG 2 1961
RECEIVED
WEST VIRGINIA
DEPT. OF MINES
JAN 1959
12345678910111213141516171819202122232425262728293031