

Company FOSTER MAYS, JR.
 Address KENNA, W. VA.
 Farm AMERICA DEEL -(J. JAMES)
 Tract _____ Acres 10 Lease No. _____
 Well (Farm) No. 1 & 3 Serial No. F-1502
 Elevation (Spirit Level) *1-946' ; *3-848'
 Quadrangle CLENDENIN
 County KANAWHA District BIG SANDY
 Engineer PAUL E. JOACHIM
 Engineer's Registration No. 669
 File No. 74-76-69 Drawing No. _____
 Date AUG. 25, 1959 Scale 1"=400'

STATE OF WEST VIRGINIA
 DEPARTMENT OF MINES
 OIL AND GAS DIVISION
 CHARLESTON

WELL LOCATION MAP

FILE NO. KAN-1284-A #1
KAN-1285-A #3

† Denotes location of well on United States Topographic Maps, scale 1 to 62,500, latitude and longitude lines being represented by border lines as shown.
 - Denotes one inch spaces on border line of original tracing.



2049
2044

STATE OF WEST VIRGINIA
DEPARTMENT OF MINES
OIL AND GAS DIVISION

Quadrangle Clebensin

WELL RECORD

Permit No. 1285A

Oil or Gas Well Oil
(KIND)


Company South Penn Natural Gas Co.
Address Box 1280, Parkersburg, W. Va.
Farm J. James Acres 174
Location (waters) Big Sandy
Well No. America Deal #3 Elev. 766
District Big Sandy County Kanawha
The surface of tract is owned in fee by _____
Address _____
Mineral rights are owned by South Penn Gas Co.
Address Parkersburg, W. Va.

Casing and Tubing	Used in Drilling	Left in Well	Packers
Size			Kind of Packer
16			R. H. Packer
13			Size of <u>6 5/8 X</u>
10			<u>8 1/4 B.H.</u>
8 3/4	430	0	Depth set
6 5/8	1608	1608	<u>1608</u>
5 3/16			Perf. top
3			Perf. bottom
2	1977	1977	Perf. top
Liners Used			Perf. bottom

Drilling commenced 11-15-19
Drilling completed 1-6-20
Date Shot 1-7-20 From 1931 To 1971
With 70 Quarts
Open Flow /10ths Water in _____ Inch
/10ths Merc. in _____ Inch
Volume _____ Cu. Ft.
Rock Pressure _____ lbs. _____ hrs.
Oil _____ bbls., 1st 24 hrs.
Fresh water 380 feet _____ feet
Salt water ~~380~~ 1070 feet _____ feet

CASING CEMENTED _____ SIZE _____ No. Ft. _____ Date _____
COAL WAS ENCOUNTERED AT _____ FEET _____ INCHES
_____ FEET _____ INCHES FEET _____ INCHES
_____ FEET _____ INCHES FEET _____ INCHES

Formation	Color	Hard or Soft	Top	Bottom	Oil, Gas or Water	Depth Found	Remarks
Surface			0	17			
Sand			17	120			
Slate			120	990			
Sand			990	1015			
Slate			1015	1030			
Salt Sand			1030	1368	Water	1070	
Slate			1368	1432			
Maxon Sand			1432	1542			
Little Lime			1542	1572			
Line			1572	1586			
Pencil Cave			1586	1592			
Big Lime			1592	1720			
Big Injun			1720	1753			
Slate			1753	1845			
Sand			1845	1890			
Slate			1890	1900			
Weir Sand			1900	1972			
Slate			1972	1979	Oil		

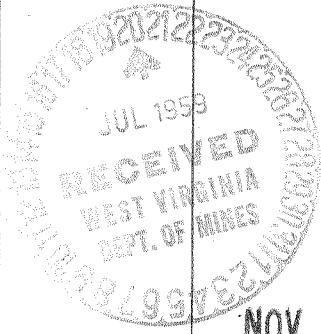

NOV 5 1959

Formation	Color	Hard or Soft	Top	Bottom	Oil, Gas or Water	Depth Found	Remarks

Date July 17, 1959

APPROVED *Berkin May Jr* Rep. Owner

By _____ (Title)

