

Company FOSTER MAYS, JR.  
 Address KENNA, W. VA.  
 Farm R. J. ESTEP  
 Tract \_\_\_\_\_ Acres 15 Lease No. \_\_\_\_\_  
 Well (Farm) No. 1 & 2 Serial No. F-1539  
 Elevation (Spirit Level) #1 - 839; #2 - 877'  
 Quadrangle CLENDENIN  
 County KANAWHA District BIG SANDY  
 Engineer PAUL E. JOACHIM  
 Engineer's Registration No. 669  
 File No. 74-69 Drawing No. \_\_\_\_\_  
 Date AUG 25, 1959 Scale 1" = 400'

STATE OF WEST VIRGINIA  
 DEPARTMENT OF MINES  
 OIL AND GAS DIVISION  
 CHARLESTON

**WELL LOCATION MAP**  
 FILE NO. KAN-1286-A #1  
KAN-1287-A #2

+ Denotes location of well on United States Topographic Maps, scale 1 to 62,500, latitude and longitude lines being represented by border lines as shown.  
 - Denotes one inch spaces on border line of original tracing.

6-0 217

R. J. ESTEP NO. 1 & 2 - FOSTER MAYS, JR. - KAN-1286-87-A



2051  
2056

STATE OF WEST VIRGINIA  
DEPARTMENT OF MINES  
OIL AND GAS DIVISION

Quadrangle Clendenin

Permit No. 1787-A

WELL RECORD

Oil or Gas Well Oil  
(KIND)

Company South Penn Natural Gas Co.  
Address Box 1280, Parkersburg, W. Va.  
Farm R. J. Estep Acres 160  
Location (waters) Big Sandy Creek  
Well No. R. J. Estep #2 Elev. 680  
District Big Sandy County Kanawha  
The surface of tract is owned in fee by R. J. Estep  
heirs Address \_\_\_\_\_  
Mineral rights are owned by South Penn Gas Co.  
Address Parkersburg, W. Va.


Casing and Tubing	Used in Drilling	Left in Well	Packers
Size			
16			Kind of Packer
13			
10			Size of
8 1/4	358	358	
6 3/4	1652	1652	Depth set
5 3/16	1684	1684	
3			Perf. top
2	1930	1930	Perf. bottom
Liners Used			Perf. top
			Perf. bottom

Drilling commenced 10-26-13  
Drilling completed 1-9-14  
Date Shot 1-15-14 From 1917 To 1923  
With 6 Quarts  
Open Flow /10ths Water in \_\_\_\_\_ Inch  
/10ths Merc. in \_\_\_\_\_ Inch  
Volume \_\_\_\_\_ Cu. Ft.  
Rock Pressure \_\_\_\_\_ lbs. \_\_\_\_\_ hrs.  
Oil \_\_\_\_\_ bbls., 1st 24 hrs.  
WELL ACIDIZED \_\_\_\_\_  
WELL FRACTURED \_\_\_\_\_

CASING CEMENTED \_\_\_\_\_ SIZE \_\_\_\_\_ No. Ft. \_\_\_\_\_ Date \_\_\_\_\_  
COAL WAS ENCOUNTERED AT \_\_\_\_\_ FEET \_\_\_\_\_ INCHES  
\_\_\_\_\_ FEET \_\_\_\_\_ INCHES FEET \_\_\_\_\_ INCHES  
\_\_\_\_\_ FEET \_\_\_\_\_ INCHES FEET \_\_\_\_\_ INCHES

RESULT AFTER TREATMENT \_\_\_\_\_  
ROCK PRESSURE AFTER TREATMENT \_\_\_\_\_  
Fresh Water 306 Feet Salt Water 1180 Feet

Formation	Color	Hard or Soft	Top	Bottom	Oil, Gas or Water	Depth	Remarks
Surface			0	16			
Slate			16	50			
Red Rock			50	70			
Sand			70	460			
Slate			460	465			
Sand			465	900			
Lime			900	940			
Slate			940	1015			
Salt Sand			1015	1490	Water	1180	
Slate			1490	1538			
Maxon Sand			1538	1580			
Slate			1580	1622			
Pencil Cave			1622	1632			
Big Lime			1632	1762			
Big Injun			1762	1812			
Squaw Sand			1812	1931	Oil & Gas		

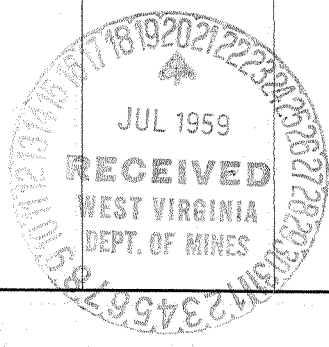

MAR 26 1960

