

Surface owned by Elizabeth Wertz.  
 Address: Mrs. Elizabeth Wertz, R.F.D. No. 1, Elkview, W. Va.  
 No Coal

New Location   
 Drill Deeper   
 Abandonment

DEC 21 1959

On 800' Map No. 100 Sqs. 571 W 50

*9.9W  
0180*

Company	<i>Pack &amp; Jackson</i>
Address	<i>Hamlin, W. Va.</i>
Farm	<i>Fred Gardner</i>
Tract	Acres <i>45 1/2</i> Lease No. _____
Well (Farm) No.	<i>6</i> Serial No. _____
Elevation (Spirit Level)	<i>762.3</i>
Quadrangle	<i>Clendenin</i>
County	<i>Kanawha</i> District <i>ELK</i>
Engineer	<i>Elsworth Haines</i>
Engineer's Registration No.	<i>2221</i>
File No.	_____ Drawing No. _____
Date	<i>Nov. 10th, 1959</i> Scale <i>1" = 400 Feet</i>

STATE OF WEST VIRGINIA  
 DEPARTMENT OF MINES  
 OIL AND GAS DIVISION  
 CHARLESTON

**WELL LOCATION MAP**  
 FILE NO. *KAN-1295-A*

+ Denotes location of well on United States Topographic Maps, scale 1 to 62,500, latitude and longitude lines being represented by border lines as shown.

- Denotes one inch spaces on border line of original tracing.

*6-0 217*

*FRED GARDNER NO. 6 PACK & JACKSON KAN-1295-A*



2058

STATE OF WEST VIRGINIA  
DEPARTMENT OF MINES  
OIL AND GAS DIVISION

Quadrangle Clendenin

Permit No. 1295-A

WELL RECORD

Oil or Gas Well Gas  
(KIND)

Company South Penn Natural Gas Co.  
Address Union Trust Bldg., Parkersburg, W. Va.  
Farm Fred Gardener Acres 45 1/2  
Location (waters) \_\_\_\_\_  
Well No. 6 Elev. 762.3  
District Elk County Kanawha  
The surface of tract is owned in fee by Mrs. Elizabeth Wertz, R.F.D. #1 Address Elkview, W. Va.  
Mineral rights are owned by \_\_\_\_\_  
Address \_\_\_\_\_

Drilling commenced \_\_\_\_\_  
Drilling completed \_\_\_\_\_  
Date Shot \_\_\_\_\_ From \_\_\_\_\_ To \_\_\_\_\_  
With \_\_\_\_\_  
Open Flow \_\_\_\_\_ /10ths Water in \_\_\_\_\_ Inch  
\_\_\_\_\_ /10ths Merc. in \_\_\_\_\_ Inch  
Volume \_\_\_\_\_ Cu. Ft.  
Rock Pressure \_\_\_\_\_ lbs. \_\_\_\_\_ hrs.  
Oil \_\_\_\_\_ bbls., 1st 24 hrs.  
WELL ACIDIZED \_\_\_\_\_  
WELL FRACTURED \_\_\_\_\_

Casing and Tubing	Used in Drilling	Left in Well	Packers
Size			Kind of Packer
16			
13			
10			Size of
8 3/4			
6 3/4	1578'	1578'	Depth set
5 3/16	1616'	1616'	
3			Perf. top
2	1950'	1950'	Perf. bottom
Liners Used			Perf. top
			Perf. bottom


CASING CEMENTED \_\_\_\_\_ SIZE \_\_\_\_\_ No. Ft. \_\_\_\_\_ Date \_\_\_\_\_  
COAL WAS ENCOUNTERED AT \_\_\_\_\_ FEET \_\_\_\_\_ INCHES  
\_\_\_\_\_ FEET \_\_\_\_\_ INCHES FEET \_\_\_\_\_ INCHES  
\_\_\_\_\_ FEET \_\_\_\_\_ INCHES FEET \_\_\_\_\_ INCHES

RESULT AFTER TREATMENT \_\_\_\_\_

ROCK PRESSURE AFTER TREATMENT \_\_\_\_\_

Fresh Water \_\_\_\_\_ Feet Salt Water \_\_\_\_\_ Feet

Formation	Color	Hard or Soft	Top	Bottom	Oil, Gas or Water	Depth	Remarks
Squaw			1816	1816	Oil	1816-1828	
Weir			1809	1870	Oil	1939	
Total depth				1987	Oil	1977-1982	

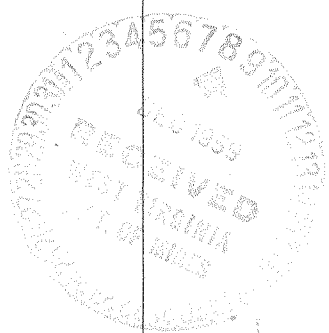

JUN 29 1960