

- New Location
- Drill Deeper
- Abandonment

Company FOSTER MAYS

Address KENNA, W. VA

Farm FRED GARDNER

Tract Acres 45 1/2 Lease No. 62877

Well (Farm) No. 1 Serial No. F-1564

Elevation (Spirit Level) 697

Quadrangle CLENDENIN

County KANAWHA District E. K

Engineer PAUL E. JOACHIM

Engineer's Registration No. 669

File No. 68-63 Drawing No.

Date MAY 25, 1960 Scale 1"=400'

STATE OF WEST VIRGINIA
DEPARTMENT OF MINES
OIL AND GAS DIVISION
CHARLESTON

WELL LOCATION MAP
FILE NO. KAN-1307-A

+ Denotes location of well on United States Topographic Maps, scale 1 to 62,500, latitude and longitude lines being represented by border lines as shown.

- Denotes one inch spaces on border line of original tracing.

6-0 217



2064

STATE OF WEST VIRGINIA
DEPARTMENT OF MINES
OIL AND GAS DIVISION

Quadrangle Clendenin W.C.

WELL RECORD

Permit No. 1307A

Oil or Gas Well Oil
(KIND)


Company Foster Mays, Jr.
Address Kenna, West Virginia
Farm Fred Gardner Acres 45 1/2
Location (waters) Elk
Well No. 1 Elev. 827
District Elk County Kanawha
The surface of tract is owned in fee by Fred Gardner
Address Jordan Creek, W. Va.
Mineral rights are owned by South Penn Natural Gas Co.
Address Parkersburg, W. Va.
Drilling commenced February, 1913
Drilling completed April, 1913
Date Shot From To
With
Open Flow /10ths Water in Inch
/10ths Merc. in Inch
Volume Cu. Ft.
Rock Pressure lbs. hrs.
Oil bbls., 1st 24 hrs.
Fresh water 320 feet feet
Salt water 764 feet feet

Casing and Tubing	Used in Drilling	Left in Well	Packers
Size			Kind of Packer
16			
13			
10			Size of
8 3/4			
6 3/4	1530	1530	Depth set
5 3/16	1550	1550	
3			Perf. top
2	1395	1395	Perf. bottom
Liners Used			Perf. top
			Perf. bottom

CASING CEMENTED SIZE No. Ft. Date

COAL WAS ENCOUNTERED AT FEET INCHES
FEET INCHES FEET INCHES
FEET INCHES FEET INCHES

Formation	Color	Hard or Soft	Top	Bottom	Oil, Gas or Water	Depth Found	Remarks
Sand			200	212			
Sand			344	486			
Sand			510	550			
Sand			900	960			
Salt Sand			960	1275			
Slate & Shells			1275	1380			
Little Lime			1380	1420			
Big Lime			1420	1550			
Big Injun Sand			1550	1600			
Slate & Shells			1600	1654			
Sand			1654	1725			
Squaw			1725	1746			
Oil			1725	1735			
Weir Sand			1854	1891			
				Total Depth	Oil	1895	

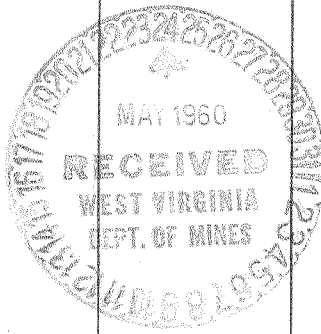

JAN 3 1961

