
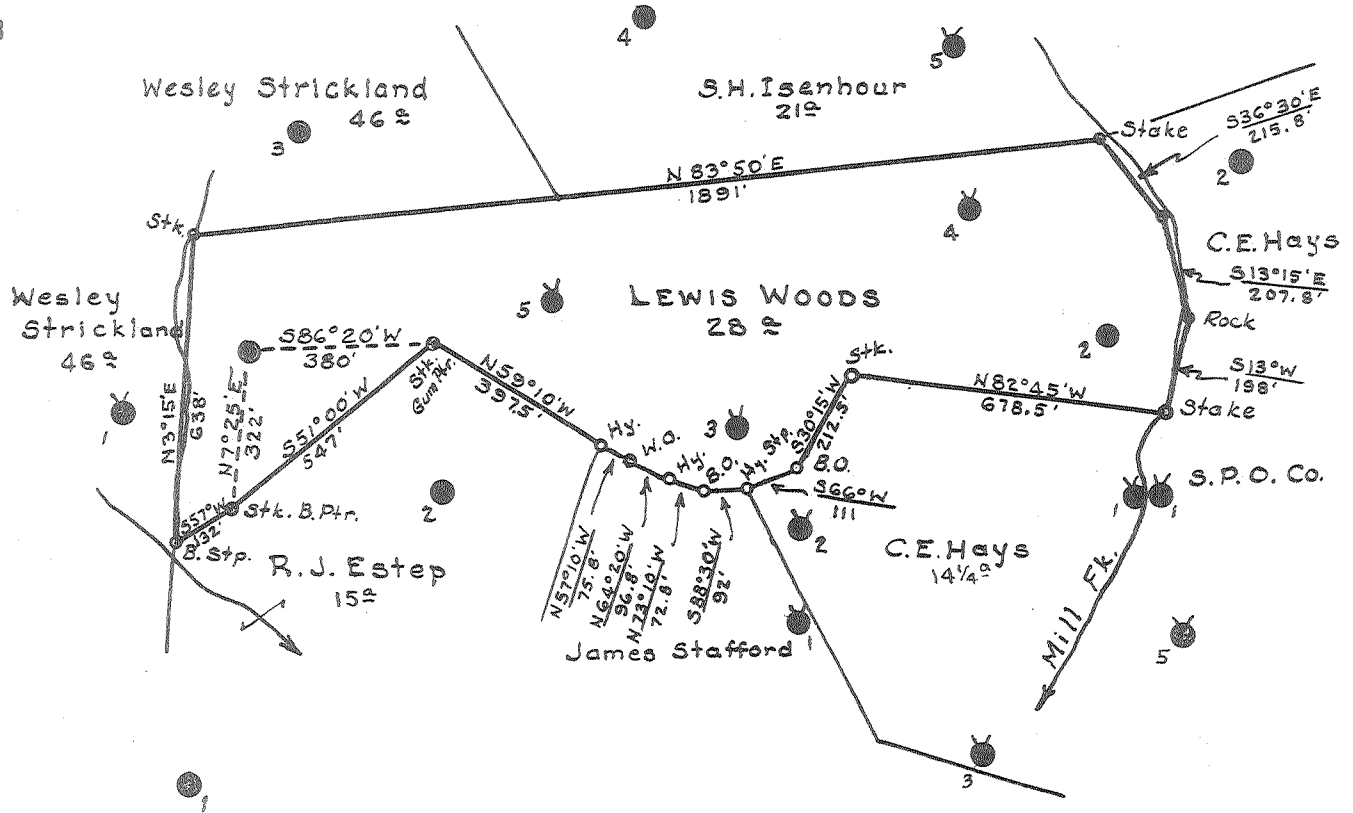


Latitude 38° 30'

Longitude 81° 20'

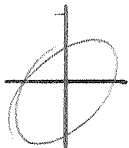

Handwritten: 40 W
1.75

JUN 27 1960

New Location
Drill Deeper
Abandonment

Company	FOSTER MAYS
Address	KENNA, W. VA.
Farm	LEWIS WOODS
Tract	Acres 28 Lease No.
Well (Farm) No.	1 Serial No. 495
Elevation (Spirit Level)	820
Quadrangle	CLENDENIN
County	KANAWHA District BIG SANDY
Engineer	PAUL E. JOACHIM
Engineer's Registration No.	669
File No.	74-67 Drawing No.
Date	JUNE 9, 1960 Scale 1" = 400'

STATE OF WEST VIRGINIA
DEPARTMENT OF MINES
OIL AND GAS DIVISION
CHARLESTON

WELL LOCATION MAP
FILE NO. KAN-1309-A

+ Denotes location of well on United States Topographic Maps, scale 1 to 62,500, latitude and longitude lines being represented by border lines as shown.
- Denotes one inch spaces on border line of original tracing.

Handwritten: 6-0 289

LEWIS WOODS No. 1 (495) — FOSTER MAYS — KAN-1309-A

2068



STATE OF WEST VIRGINIA
DEPARTMENT OF MINES
OIL AND GAS DIVISION

Quadrangle Cumber

Permit No. 1309A

WELL RECORD

Oil or Gas Well Oil
(KIND)


Company Foster Mays, Jr.
 Address Kenna, West Virginia
 Farm Lewis Woods Acres 75
 Location (waters) Big Sandy
 Well No. No. 1 (690) Elev. 1010
 District Big Sandy County Kanawha
 The surface of tract is owned in fee by Lewis Woods
 Address Clendenin, W. Va.
 Mineral rights are owned by South Penn Natural Gas
 Company Address Parkersburg, W. Va.
 Drilling commenced September, 1915
 Drilling completed December, 1915
 Date Shot From _____ To _____
 With _____
 Open Flow /10ths Water in _____ Inch
 /10ths Merc. in _____ Inch
 Volume _____ Cu. Ft.
 Rock Pressure _____ lbs. _____ hrs.
 Oil _____ bbls., 1st 24 hrs.
 Fresh water 369 feet _____ feet
 Salt water 1020 feet _____ feet

Casing and Tubing	Used in Drilling	Left in Well	Packers
Size			
16			Kind of Packer
13			
10			Size of
8 3/4	<u>194</u>	<u>194</u>	
6 3/4	<u>1677 1/2</u>	<u>1677 1/2</u>	Depth set
5 3/16			
3			Perf. top
2	<u>1921</u>	<u>1921</u>	Perf. bottom
Liners Used			Perf. top
			Perf. bottom

CASING CEMENTED _____ SIZE _____ No. Ft. _____ Date _____

COAL WAS ENCOUNTERED AT _____ FEET _____ INCHES
 _____ FEET _____ INCHES _____ FEET _____ INCHES
 _____ FEET _____ INCHES _____ FEET _____ INCHES

Formation	Color	Hard or Soft	Top	Bottom	Oil, Gas or Water	Depth Found	Remarks
Sand			0	30			
Slate			30	40			
Rocks			40	50			
Slate			50	125			
Sand			125	130			
Slate			130	200			
Sand			200	240			
Slate			240	320			
Sand			320	440			
Slate			440	520			
Sand			520	650			
Slate			650	720			
Sand			720	750			
Lime & Shells			750	825			
Slate			825	910			
Lime & Shells			910	935			
Slate			935	1030			
Salt Sand			1030	1430			
Slate			1430	1485			
Red Rocks			1485	1495			
Slate			1495	1510			
Lime & Shells			1510	1560			
Maxon Sand			1560	1583			
Slate			1583	1590			
Little Lime			1590	1627			
Pencil Cave			1627	1633			
Pencil			1633	1641			
Big Lime			1641	1786			
Big Injun			1786	1816			
Slate			1816	1876			
Lime			1876	1891			
Slate & Shells			1891	1919			
Squaw Sand			1919	1934			
Oil			1921	1934	<u>Oil</u>		
				Total Depth		<u>1936</u>	

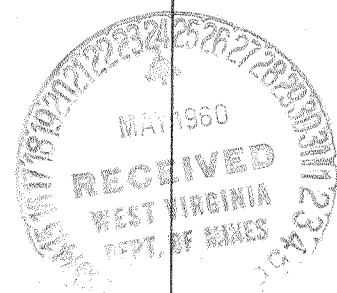

Formation	Color	Hard or Soft	Top	Bottom	Oil, Gas or Water	Depth Found	Remarks

Date May 4, 19 60
 APPROVED J. W. May Jr., Owner
 By Owner
 (Title)