
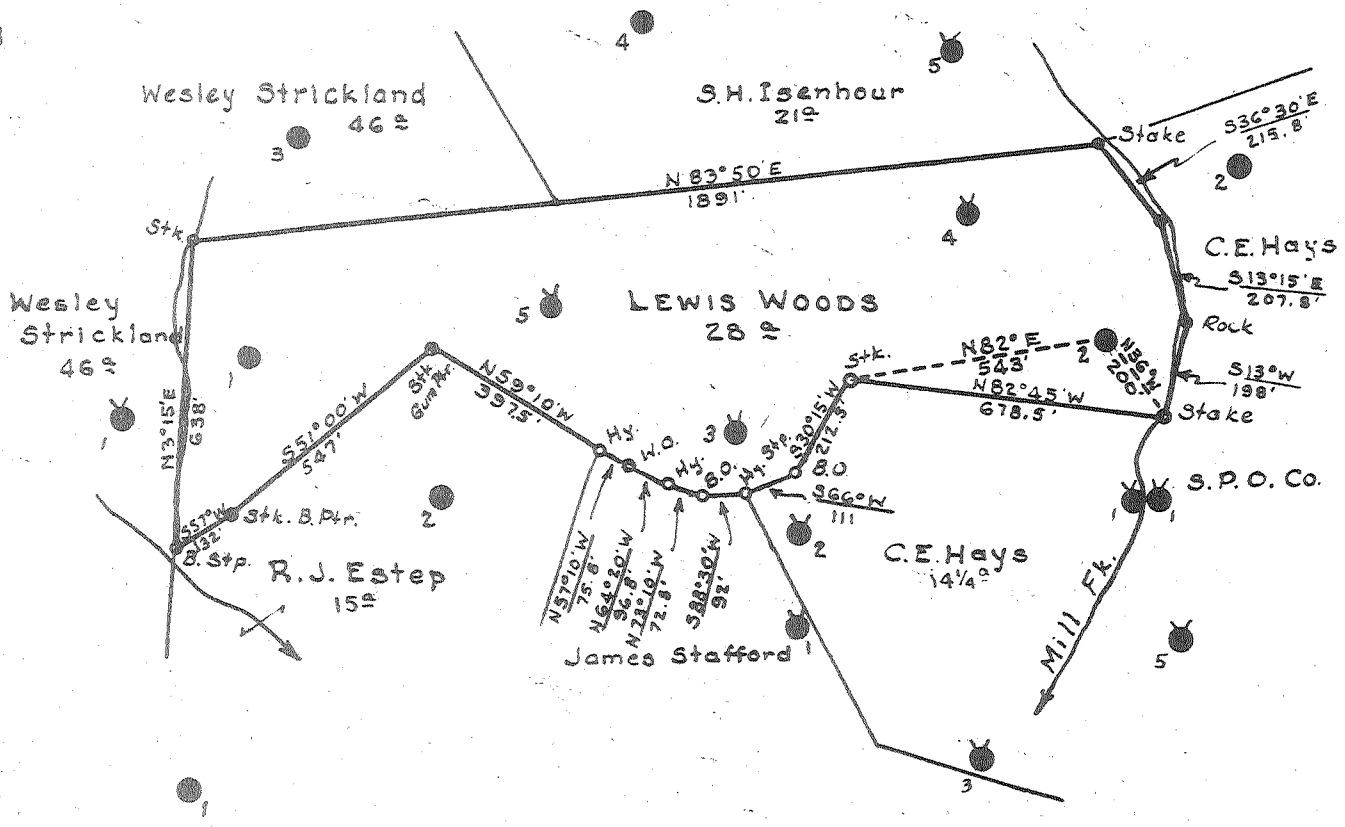


Latitude 38 30'

Longitude 81° 20'

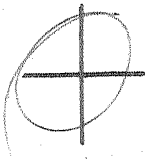

New Location
Drill Deeper
Abandonment

JUL 3 1960

*317 W
1280*

Company FOSTER MAYS
 Address KENNA, W. VA.
 Farm LEWIS WOODS
 Tract _____ Acres 28 Lease No. _____
 Well (Farm) No. 2 Serial No. 496
 Elevation (Spirit Level) 695
 Quadrangle CLENDENIN
 County KANAWHA District BIG SANDY
 Engineer PAUL E. JOACHIM
 Engineer's Registration No. 669
 File No. 74-67 Drawing No. _____
 Date JUNE 9, 1960 Scale 1" = 400'

STATE OF WEST VIRGINIA
DEPARTMENT OF MINES
OIL AND GAS DIVISION
CHARLESTON

WELL LOCATION MAP
FILE NO. KAN-1310-A

+ Denotes location of well on United States Topographic Maps, scale 1 to 62,500, latitude and longitude lines being represented by border lines as shown.

- Denotes one inch spaces on border line of original tracing.

LEWIS WOODS no. 2 (A 96) - FOSTER MAYS - KAN-1310-A



2069

STATE OF WEST VIRGINIA
DEPARTMENT OF MINES
OIL AND GAS DIVISION

Quadrangle Clendonin W. Va.
Permit No. 136-A

WELL RECORD


Oil or Gas Well Oil
(KIND)

Company Foster Mays, Jr.
Address Kenna, West Virginia
Farm Lewis Woods Acres 75
Location (waters) Big Sandy
Well No. No. 2 (496) Elev. 709
District Big Sandy County Kanawha
The surface of tract is owned in fee by Lewis Woods
Address Clendonin, W. Va.
Mineral rights are owned by South Penn Natural Gas Company
Address Parkersburg, W. Va.
Drilling commenced May, 1915
Drilling completed August, 1915
Date Shot From To
With
Open Flow /10ths Water in Inch
/10ths Merc. in Inch
Volume Cu. Ft.
Rock Pressure lbs. hrs.
Oil bbls., 1st 24 hrs.
Fresh water 312 feet feet
827
Salt water feet feet

Casing and Tubing	Used in Drilling	Left in Well	Packers
Size			Kind of Packer
16			
13			
10			Size of
8 1/4	<u>419</u>	<u>419</u>	
6 1/2	<u>1532</u>	<u>1532</u>	Depth set
5 3/16			
3			Perf. top
2	<u>1790</u>	<u>1790</u>	Perf. bottom
Liners Used			Perf. top
			Perf. bottom

CASING CEMENTED SIZE No. Ft. Date
COAL WAS ENCOUNTERED AT FEET INCHES
FEET INCHES FEET INCHES
FEET INCHES FEET INCHES

Formation	Color	Hard or Soft	Top	Bottom	Oil, Gas or Water	Depth Found	Remarks
Lime			11	35			
Slate			35	85			
Sand			85	120			
Slate			120	200			
Sand			200	250			
Slate			250	285			
Sand			285	350			
Slate			350	410			
Sand			410	465			
Slate			465	500			
Sand			500	585			
Slate			585	620			
Sand			620	700			
Slate			700	825			
Sand			825	875			
Slate			875	900			
Salt Sand			900	1300			
Slate			1300	1310			
Lime			1310	1325			
Slate			1325	1340			
Lime			1340	1360			
Slate			1360	1370			
Red Rock			1370	1400			
Lime			1400	1410			
Slate			1410	1420			
Maxon Sand			1420	1445			
Slate			1445	1460			
Lime			1460	1465			
Slate			1465	1470			
Little Lime			1470	1494			
Slate			1494	1501			
Lime			1501	1503			
Slate			1503	1506			
Lime			1506	1510			
Pencil Cave			1510	1518			
Big Lime			1518	1648			

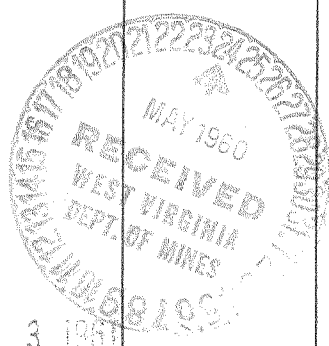

JAN 3 1961

Formation	Color	Hard or Soft	Top	Bottom	Oil, Gas or Water	Depth Found	Remarks
Sand			1648	1700			
Slate			1700	1730			
Red Rock			1730	1750			
Slate			1750	1775			
Squaw			1775	1788			
				Total Depth	1788		

Date May 14, 1910
 APPROVED Walter Mays, Owner
 By Owner
 (Title)