

Company KREBS OIL COMPANY

Address Box 213 - CHARLESTON, W.VA

Farm M.A. COBB

Tract 1 Acres 2 (+) Lease No. 1

Well (Farm) No. 2 Serial No. _____

Elevation (Spirit Level) 714'

Quadrangle CLENDENIN

County KANAWHA District BIG SANDY

Engineer C.S. Krebs

Engineer's Registration No. 773

File No. _____ Drawing No. _____

Date 7-26-61 Scale 1" = 100'

STATE OF WEST VIRGINIA
 DEPARTMENT OF MINES
 OIL AND GAS DIVISION
 CHARLESTON

WELL LOCATION MAP
 FILE NO. KAN-1321-A

+ Denotes location of well on United States Topographic Maps, scale 1 to 62,500, latitude and longitude lines being represented by border lines as shown.

- Denotes one inch spaces on border line of original tracing.

M.A. COBB No. 2 - KREBS OIL Co - KAN-1321-A



Completed 7086

STATE OF WEST VIRGINIA
DEPARTMENT OF MINES
OIL AND GAS DIVISION

OC

Quadrangle Clendenin

WELL RECORD

Permit No. Kay-1321A

Oil or Gas Well GAS
(KIND)


Company Krebs Oil Company
 Address Box 213, Charleston, W. Va.
 Farm M. A. Cobb Acres 2 (I)
 Location (waters) Big Sandy
 Well No. 2 (Serial No. L-858) Elev. 714'
 District Big Sandy County Kanawha
 The surface of tract is owned in fee by M. A. Cobb, Hrs.
 Address _____
 Mineral rights are owned by M. A. Cobb, Hrs.
 Address _____
 Drilling commenced May 6, 1920
 Drilling completed June 14, 1920
 Date Shot _____ From _____ To _____
 With _____
 Open Flow _____ /10ths Water in _____ Inch
 _____ /10ths Merc. in _____ Inch
 Volume _____ Cu. Ft.
 Rock Pressure _____ lbs. _____ hrs.
 Oil _____ bbls., 1st 24 hrs.
 Fresh water _____ feet _____ feet
 Salt water _____ feet _____ feet

Casing and Tubing	Used in Drilling	Left in Well	Packers
Size			Kind of Packer
16			
13			
10	27'	27'	Size of
8 1/4	425'	425'	
6 5/8	1314'	1314'	Depth set
5 3/16			
3			Perf. top
2			Perf. bottom
Liners Used			Perf. top
			Perf. bottom

CASING CEMENTED _____ SIZE _____ No. Ft. _____ Date _____

COAL WAS ENCOUNTERED AT _____ FEET _____ INCHES
 _____ FEET _____ INCHES _____ FEET _____ INCHES
 _____ FEET _____ INCHES _____ FEET _____ INCHES

Formation	Color	Hard or Soft	Top	Bottom	Oil, Gas or Water	Depth Found	Remarks
Gravel			00	27			
Sand			27	50			
Slate			50	255			
Sand			255	325			
Slate			325	660			
Sand			660	1010			
Slate			1010	1015			
Sand			1015	1260			
Slate			1260	1262			
Little Lime			1262	1302			
Pencil Cave			1302	1310			
Big Lime			1310	1448			
Slate and Shells			1448	1537			
Weir Sand			1537	1681			
Slate			1681	1709			
Gas -	1590-1625						
Gas -	1677-1681						
TOTAL DEPTH				1709			

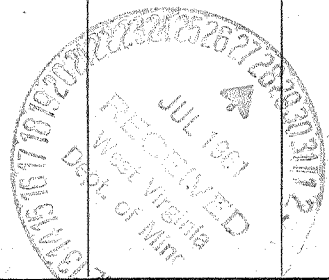

APR 6 1962