


- NEW LOCATION
- RECONDITION
- DRILL DEEPER
- ABANDONMENT

"I, the undersigned, hereby certify that this map is correct to the best of my knowledge and belief and shows all the information required by paragraph 6 of the rules and regulations of the oil and gas section of the mining laws of West Virginia."

Minimum degree of accuracy is one part in 200

Signed James A. Rufford

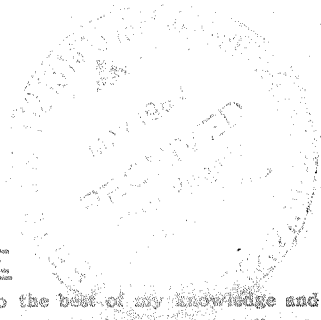

CERTIFICATE

COMPANY	A. A. PURSLEY		
ADDRESS	LEROY, W. VA.		
FARM	W. H. HUDNALL		
MAP	ACRES	LEASE NO.	
WELL (FARM) NO.	1	SERIAL NO. 1718 V. G. & O.	
ELEVATION (SPIRIT LEVEL)	775'		
QUADRANGLE	GLENDEIN SE		
COUNTY	KANAWHA	DISTRICT CABIN CREEK	
POINT OF PROVEN ELEVATION	B. M. APPROX. 2 1/2 MILES		
	N72°E OF LOC. - B.M. ELEV. - 1005'		
FILE NO.	DRAWING NO.		
DATE	SCALE		
JAN. 1967	1" = 100'		

STATE OF WEST VIRGINIA
 DEPARTMENT OF MINES
 OIL AND GAS DIVISION
 CHARLESTON
 WELL LOCATION MAP

FILE NO. JAN-1388-9

+ DENOTES LOCATION OF WELL ON UNITED STATES TOPOGRAPHIC MAPS. SCALE 1 TO 62,500. LATITUDE AND LONGITUDE LINES BEING REPRESENTED BY BORDER LINES AS SHOWN.

- DENOTES ONE INCH SPACES ON BORDER LINE OF ORIGINAL TRACING.