


LATITUDE 38° 25'

LONGITUDE 81° 30'

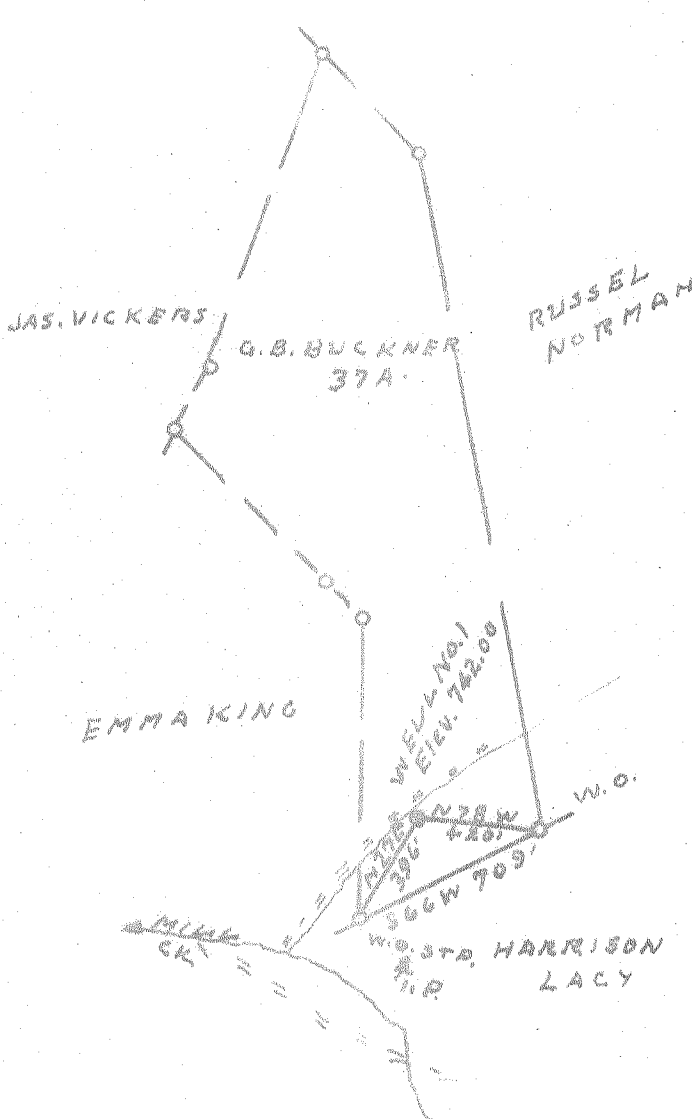

+ 295
120 W

Minimum Error of Closure 1' IN 200

Source of Elevation FOURK'S ROAD WEST 708.00

I, the undersigned, hereby certify that this map is correct to the best of my knowledge and belief and shows all the information required by paragraph 6 of the rules and regulations of the oil and gas section of the mining laws of West Virginia.

- Fracture.....
- New Location.....
- Drill Deeper.....
- Abandonment.....

Signed: A. B. King
 Squares: N S E W

Map No.

Company COVELL OIL & GAS CO.
 Address 308 JARVIS ST. CHARLESTON
 Farm G. B. BUCKNER
 Tract _____ Acres 32 Lease No. _____
 Well (Farm) No. 1 Serial No. _____
 Elevation (Spirit Level) 742.00
 Quadrangle CHARLESTON EC
 County KANAWHA District ELK
 Engineer A. B. King
 Engineer's Registration No. 204
 File No. _____ Drawing No. _____
 Date 4-27-67 Scale 1" = 40 FEET

STATE OF WEST VIRGINIA
 DEPARTMENT OF MINES
 OIL AND GAS DIVISION
 CHARLESTON

WELL LOCATION MAP

FILE NO. KAN-1391-A

+ Denotes location of well on United States Topographic Maps, scale 1 to 62,500, latitude and longitude lines being represented by border lines as shown.

- Denotes one inch spaces on border line of original tracing.